

MICROFILMED

PLAT AND RECORD


Of a Survey on Section 13 T 3 R 13 E. of the 4 P. M. in Harmony Township

Rock County, Wisconsin, made May the 4 1878

I hereby certify that the following is a correct record of said survey as made by me.

COUNTY BUILDING
CITY OF JANESVILLE

(Signed) Edward Ruger
R. H. B. County Surveyor.

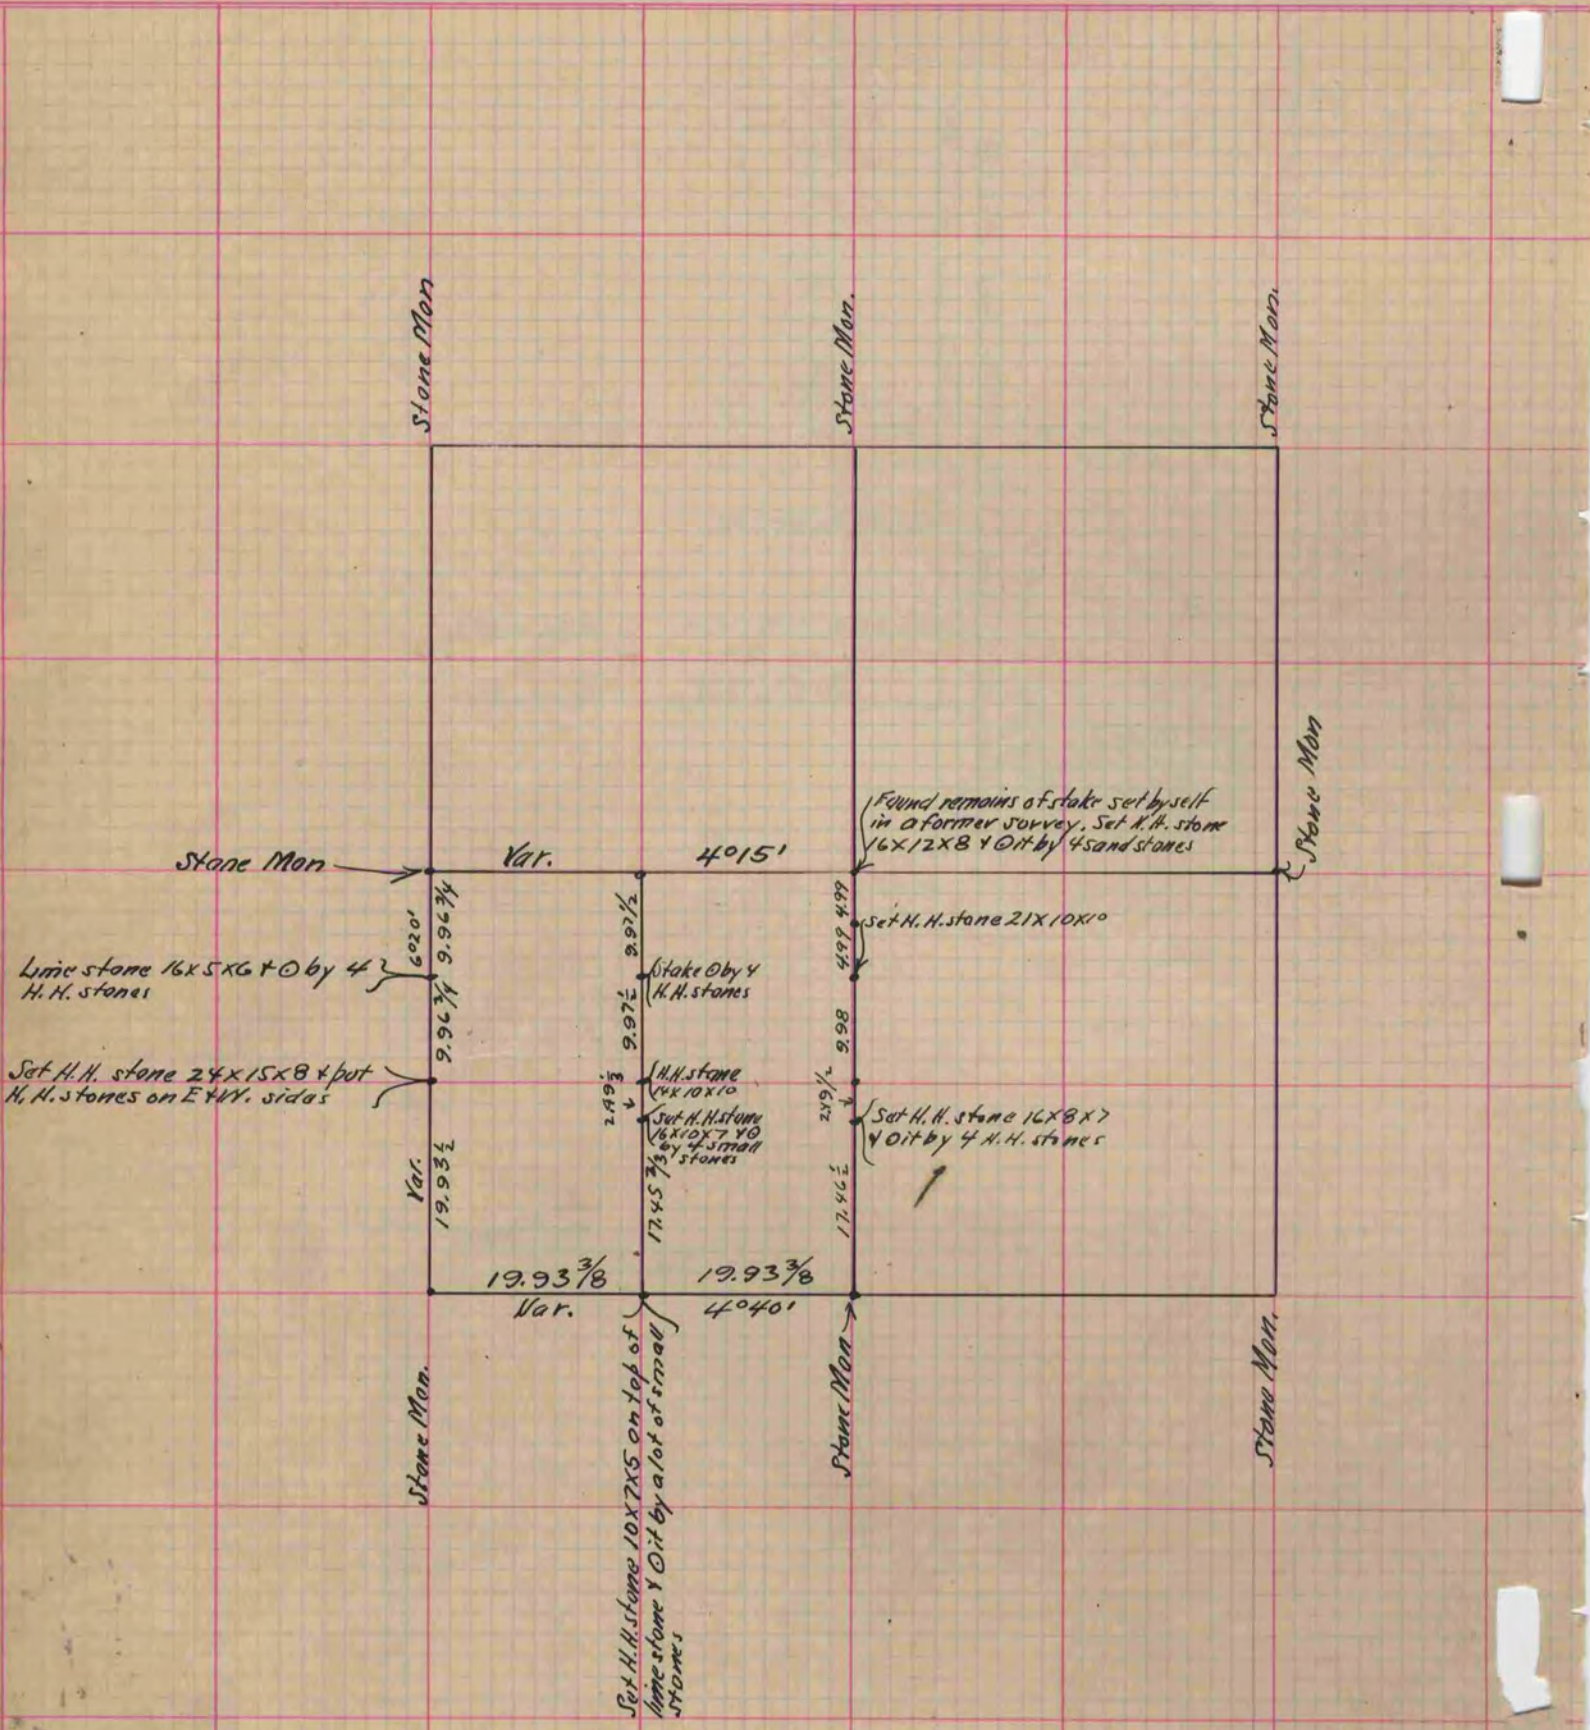

Copied From Page 204 Vol. 2. County Surveyors Record.