

MICROFILMED

PLAT AND RECORD

125
V-2


COUNTY BUILDING 1
CITY OF JANESVILLE

Of a Survey on Section 32 T 2 R 14 E. of the 4 P. M. in Bradford Township

Rock County, Wisconsin, made February the 4th 1874

I hereby certify that the following is a correct record of said survey as made by me.

(Signed) Edward Ruger
R. H. B. County Surveyor.

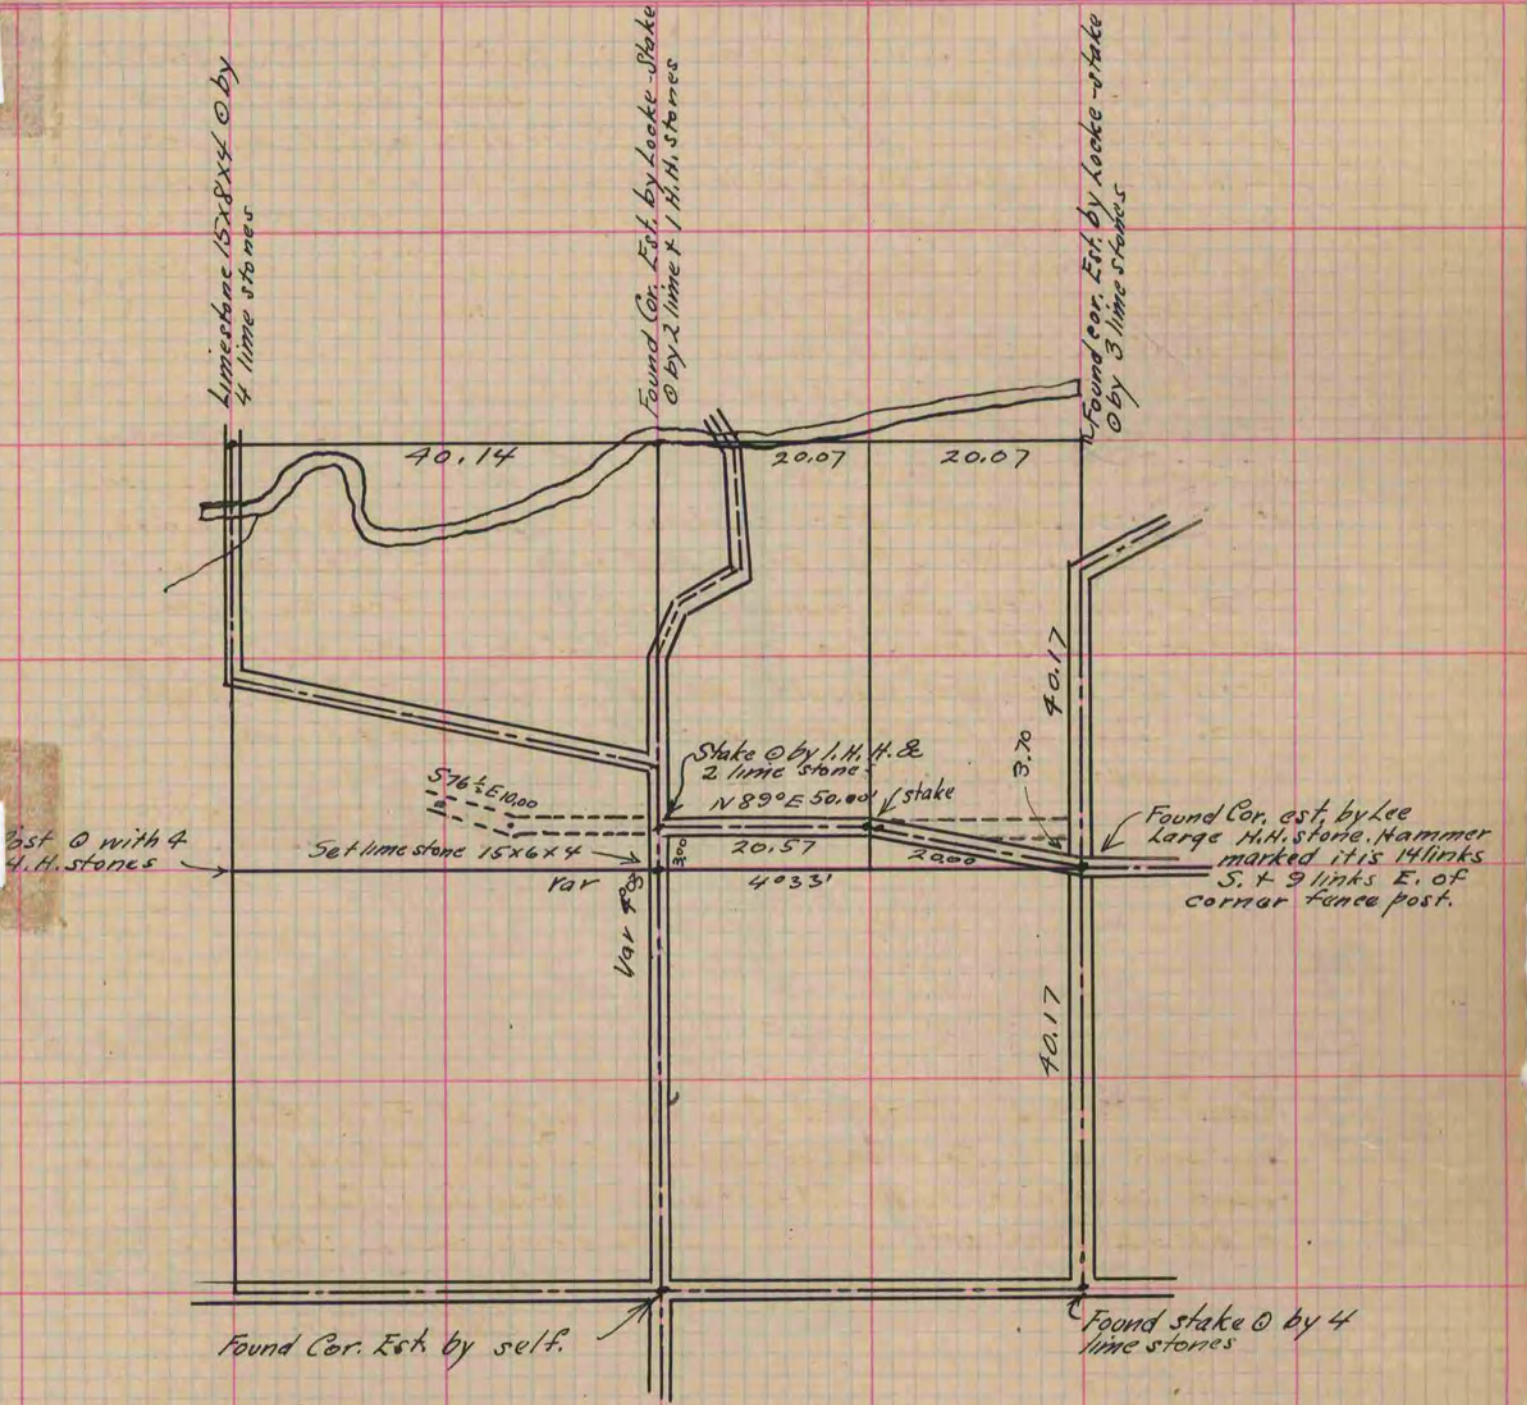

Copied from Page 83 Volume 2 Original County Surveyors Record