

MICROFILMED

PLAT AND RECORD

75
v-2


COUNTY BUILDING
CITY OF JANESVILLE

Of a Survey on Section 33 T 2 R 11 E. of the 4 P. M. in Plymouth Township

Rock County, Wisconsin, made October the 9-10 1871

I hereby certify that the following is a correct record of said survey as made by me.

(Signed) Edward Ruger
R.H.B. County Surveyor.

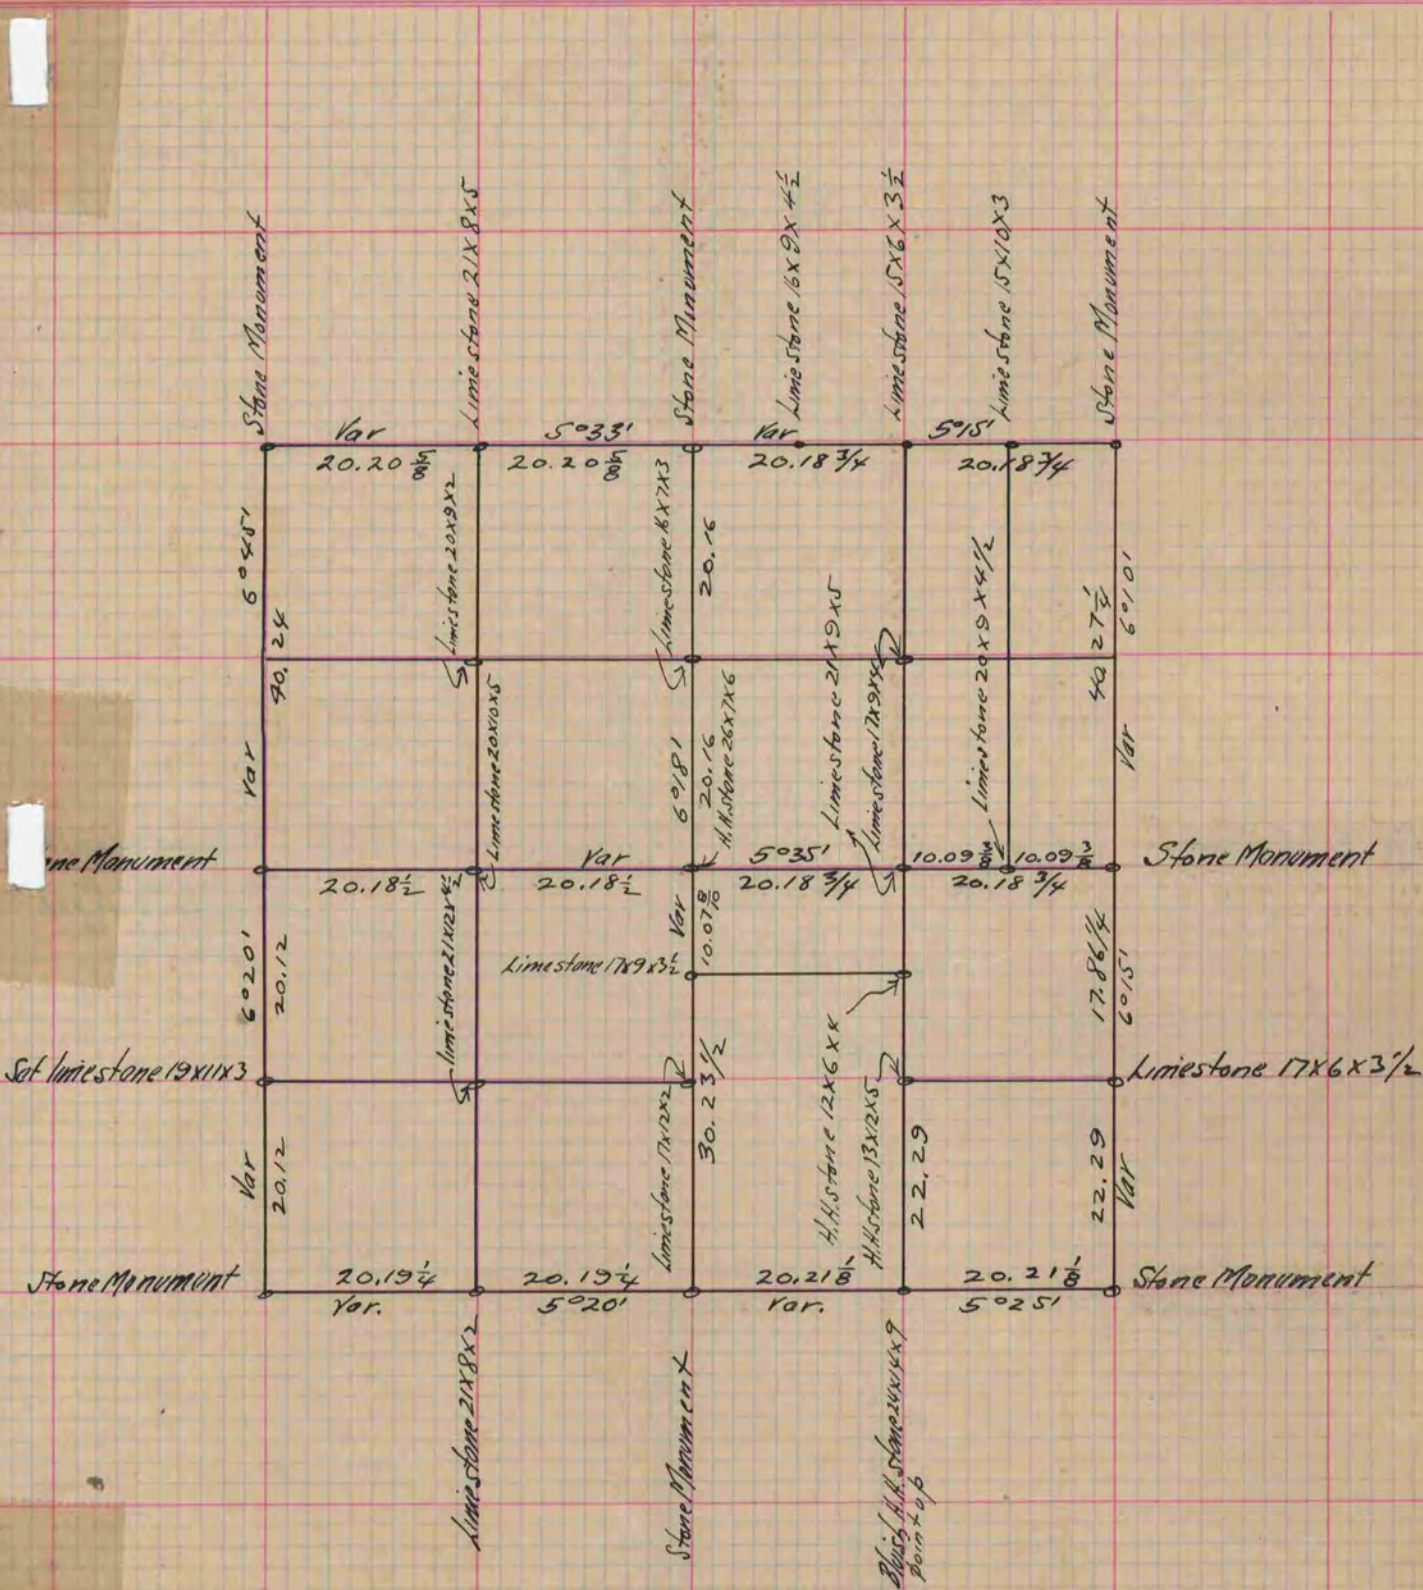

Copied from Page 45 Vol. 2 Original County Surveyors Record