

PLAT AND RECORD

COUNTY BUILDING
CITY OF JANESVILLE

229


V-5

Of a Survey on Section 38.9 T 4 R 12 E. of the 4 P. M. in FULTON Township

Rock County, Wisconsin, made NOV the 23 8 29 1976

I hereby certify that the following is a correct record of said survey as made by me.

MICROFILMED

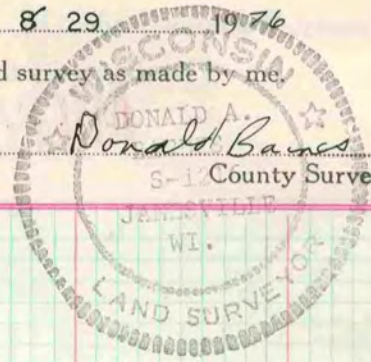

NW COR SEC 3

FD HH 5"X 8"X 12" O 3 HH & 2 METAL STRAPS
SET ALUM MON.

