

292 VOL. 5 PLAT AND RECORD

Of a Survey on Section 17, 19 T 1 N R 10 E. of the 4 P. M. in AVON Township  
 Rock County, Wisconsin, made JUNE the 14 1977


I hereby certify that the following is a correct record of said survey as made by me,

COUNTY BUILDING  
 CITY OF JANESVILLE

Donald A. Barnes  
 J. Barnes  
 WI. County Surveyor.



MICROFILMED

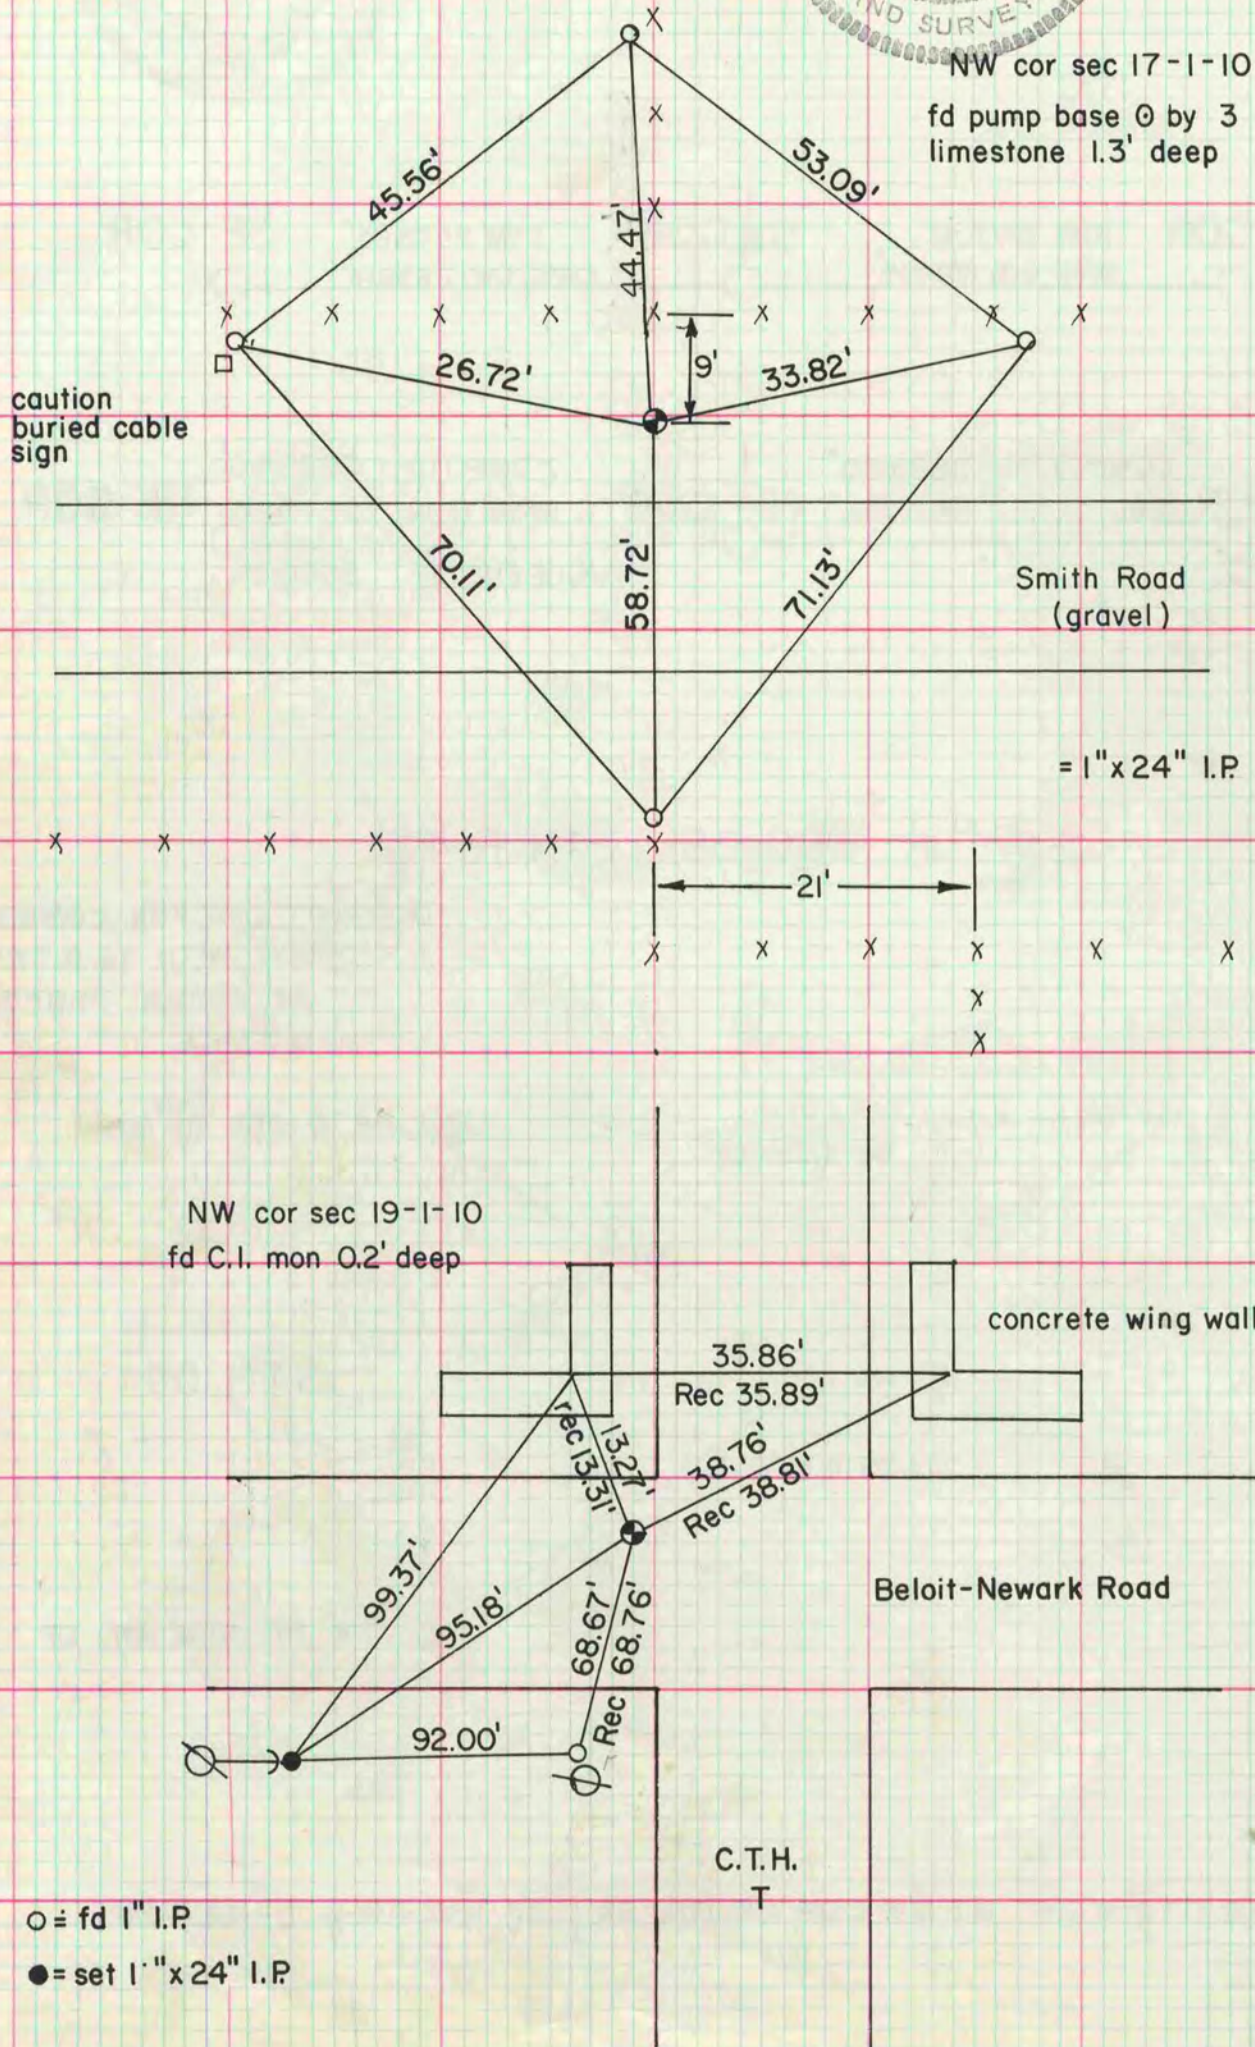

$\odot$  = fd 1" I.P.  
 $\bullet$  = set 1" x 24" I.P.