

MICROFILMED PLAT AND RECORD

3
V-3

Of a Survey on Section 29 T 1 R 14 E. of the 4 P. M. in Clinton Township


Rock County, Wisconsin, made May the 12 1901

I hereby certify that the following is a correct record of said survey as made by me.

COUNTY BUILDING
CITY OF JANESVILLE

C. V. Kerck

County Surveyor.

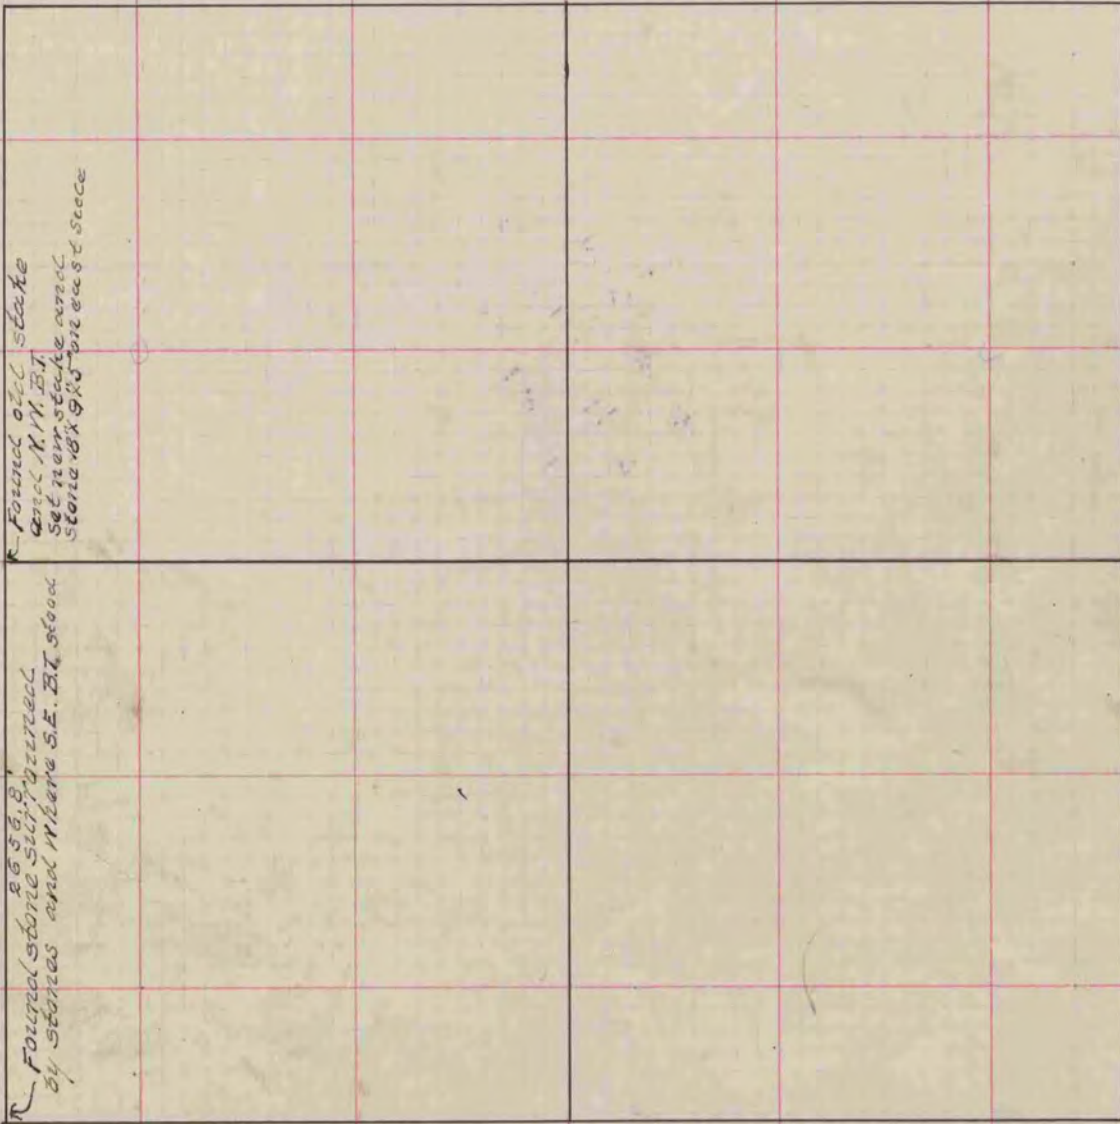

✓ RUGER BOOK 62 COPIED FROM BELOIT REC 12/12/75 DAB
RED H.H. 14"x7 1/2"x3" @ 4HH