


COUNTY BUILDING
CITY OF JANESVILLE

Of a Survey on Section 23 T. 2 R. 14 E. of the 4 P. M. in Bradford Township
Rock County, Wisconsin, made October 20, 1977


I hereby certify that the following is a correct record of said survey as made by me.

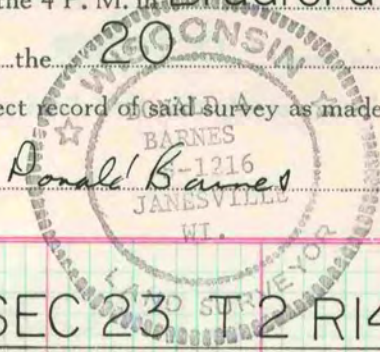

County Surveyor.

S 1/16 COR NE 1/4 SEC 23 T 2 R 14 E

FD 2" I.P.

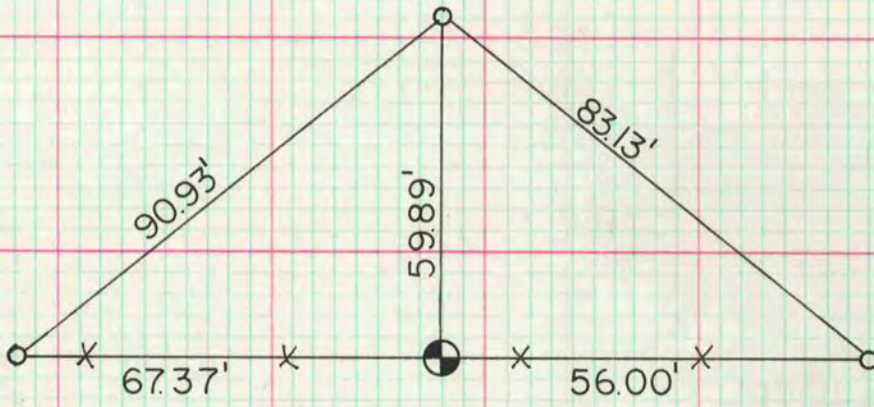

o 1" X 24" I.P.

MICROFILMED