

# PLAT AND RECORD

COUNTY BUILDING  
CITY OF JANESVILLE


**MICROFILMED**

Of a Survey on Section 7 T 2 R 10 E. of the 4 P. M. in Spring Valley Township  
Rock County, Wisconsin, made November the 20th + 21st 1868

I hereby certify that the following is a correct record of said survey as made by me.

COUNTY BUILDING  
CITY OF JANESVILLE

(Signed) R. K. Lee  
R.H.B. Deputy County Surveyor.

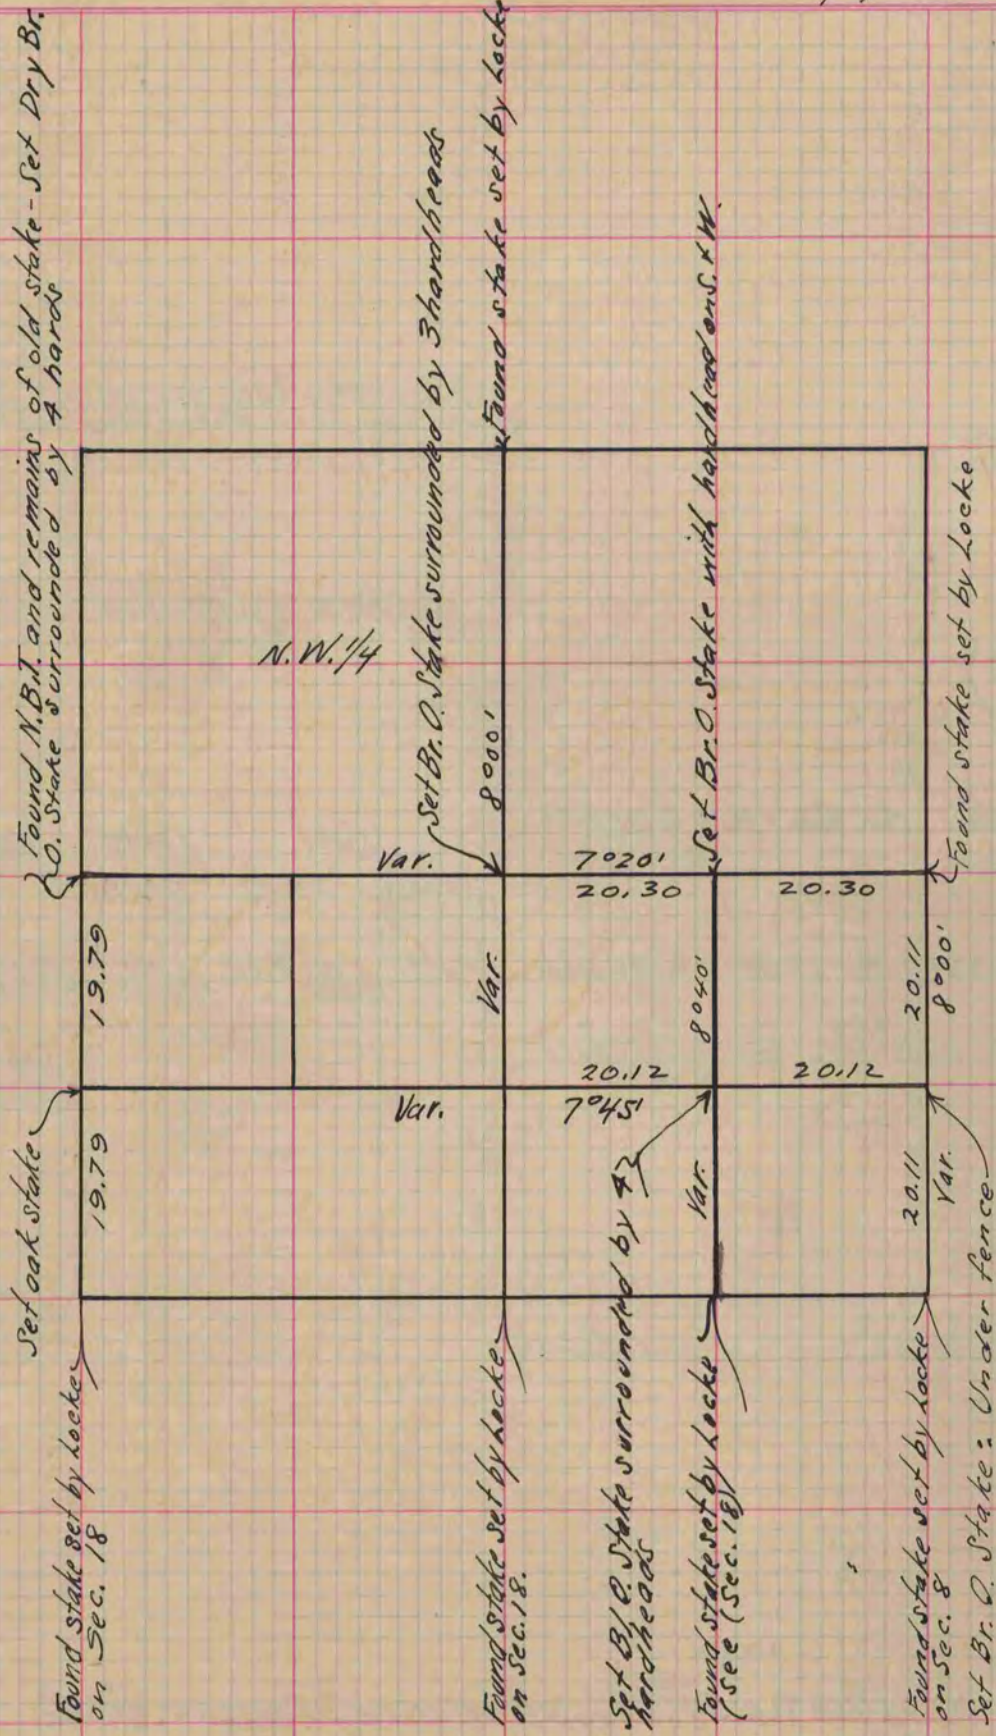

Copied from Page 275 Vol. 1. Original County Surveyors Record