

# PLAT AND RECORD

VOL. 5

339


COUNTY BUILDING  
CITY OF JANESVILLE

Of a Survey on Section 28 T. 4 R. 13 E. of the 4 P. M. in MILTON Township

Rock County, Wisconsin, made SEPTEMBER the 30 1977


I hereby certify that the following is a correct record of said survey as made by me.

COUNTY BUILDING  
CITY OF JANESVILLE

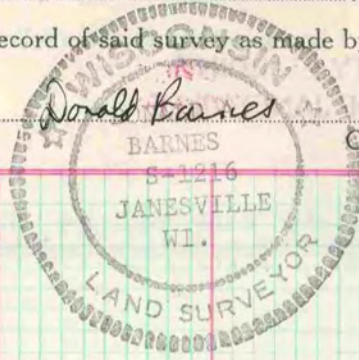

County Surveyor.

S 1/4 COR. SEC. 28 T. 4 R. 13 E.

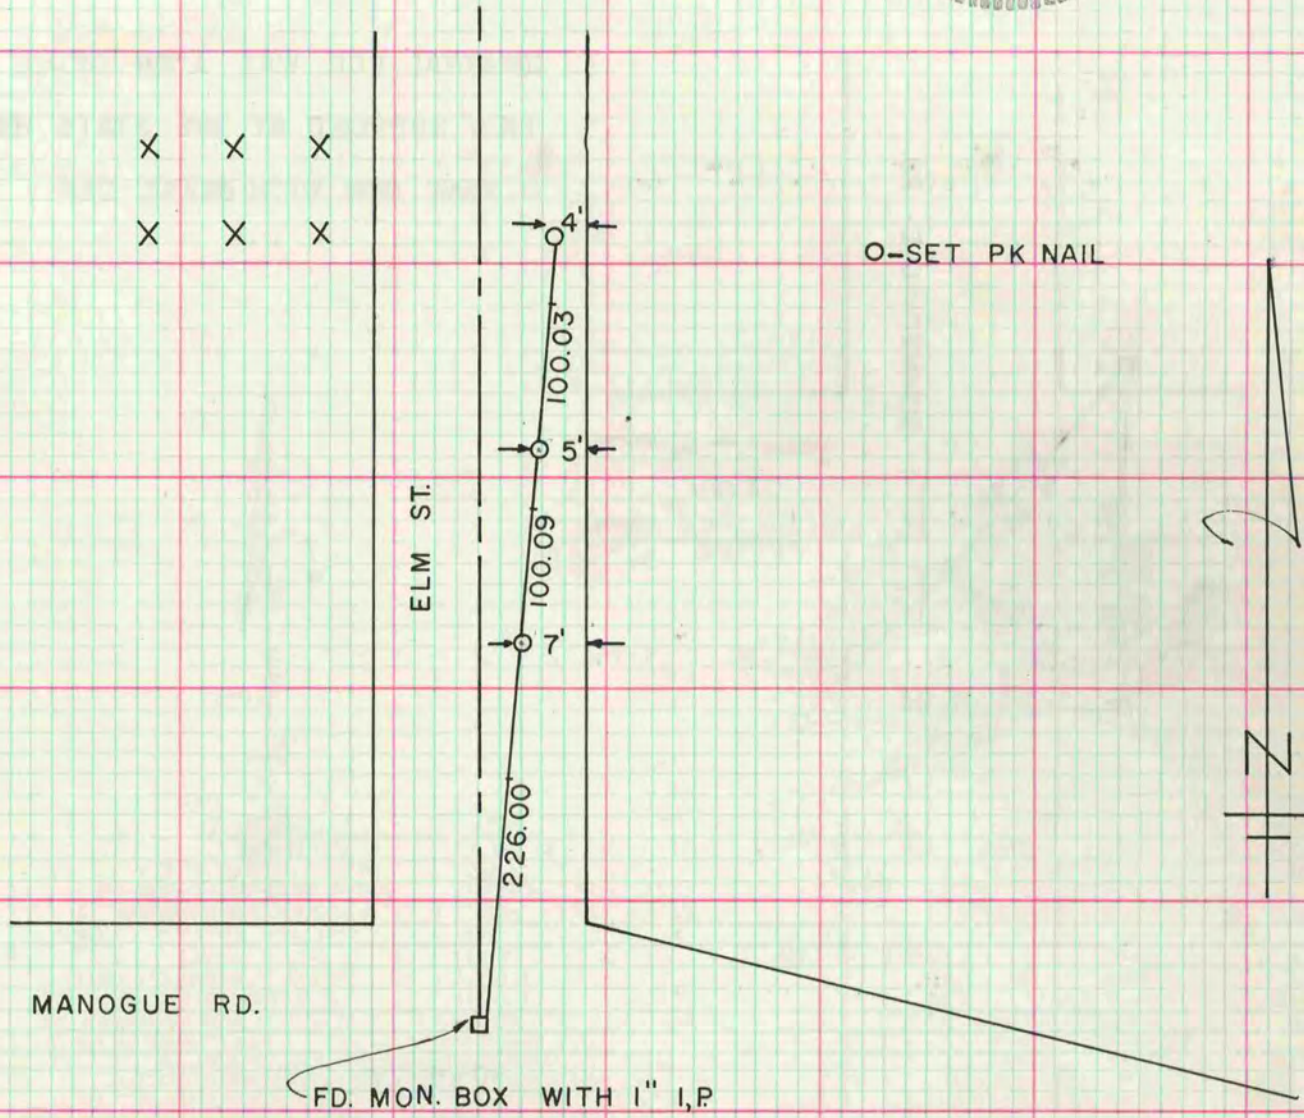

MICROFILMED