

PLAT AND RECORD

133
V-5

COUNTY BUILDING
CITY OF JANESVILLE

COURT BUILDING
CITY OF JANESVILLE

Of a Survey on Section II T. 4 N R. 13 E. of the 4 P. M. in MILTON Township


Rock County, Wisconsin, made March the 13 1976

I hereby certify that the following is a correct record of said survey as made by me

Donald Baines

County Surveyor.

MICROFILMED

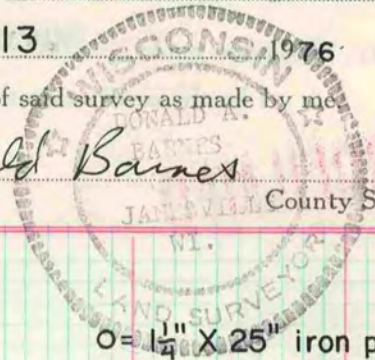

○ = 1/4" X 25" iron pipe

