


MICROFILMED PLAT AND RECORD

233
V-2

Of a Survey on Section 23 T 3 R 13 E. of the 4 P. M. in Harmony Township
 Rock County, Wisconsin, made November the 15, 16, 17 & 19 1877

I hereby certify that the following is a correct record of said survey as made by me.
COUNTY BUILDING
CITY OF JANESVILLE

(Signed) Edward Ruger
 R.H.B. County Surveyor.

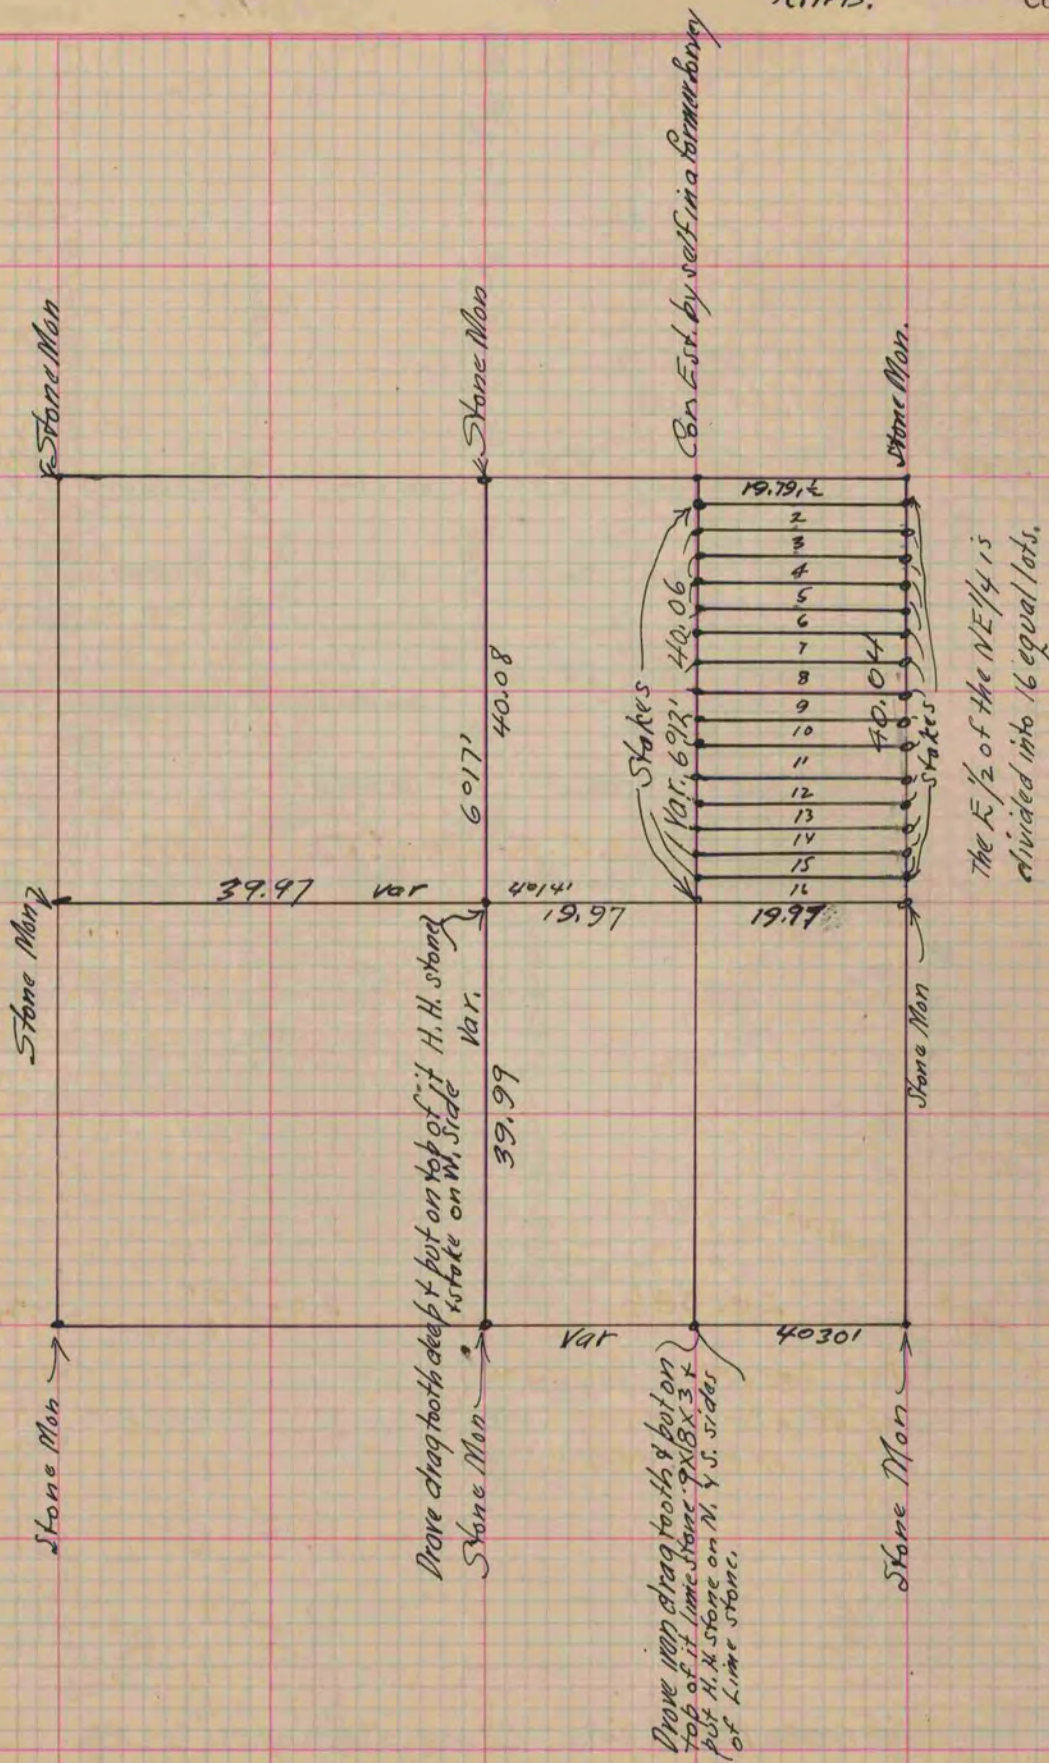

copied from page 187 Vol. 2. County Surveyors Record