

# PLAT AND RECORD

**MICROFILMED**


Of a Survey on Section 6 T 2 R 12 E. of the 4 P. M. in Rock Township

Rock County, Wisconsin, made May the 26<sup>th</sup> 1881

I hereby certify that the following is a correct record of said survey as made by me.

COUNTY BUILDING  
CITY OF JANESVILLE

(Signed) R. K. Lee  
R. H. B. County Surveyor.

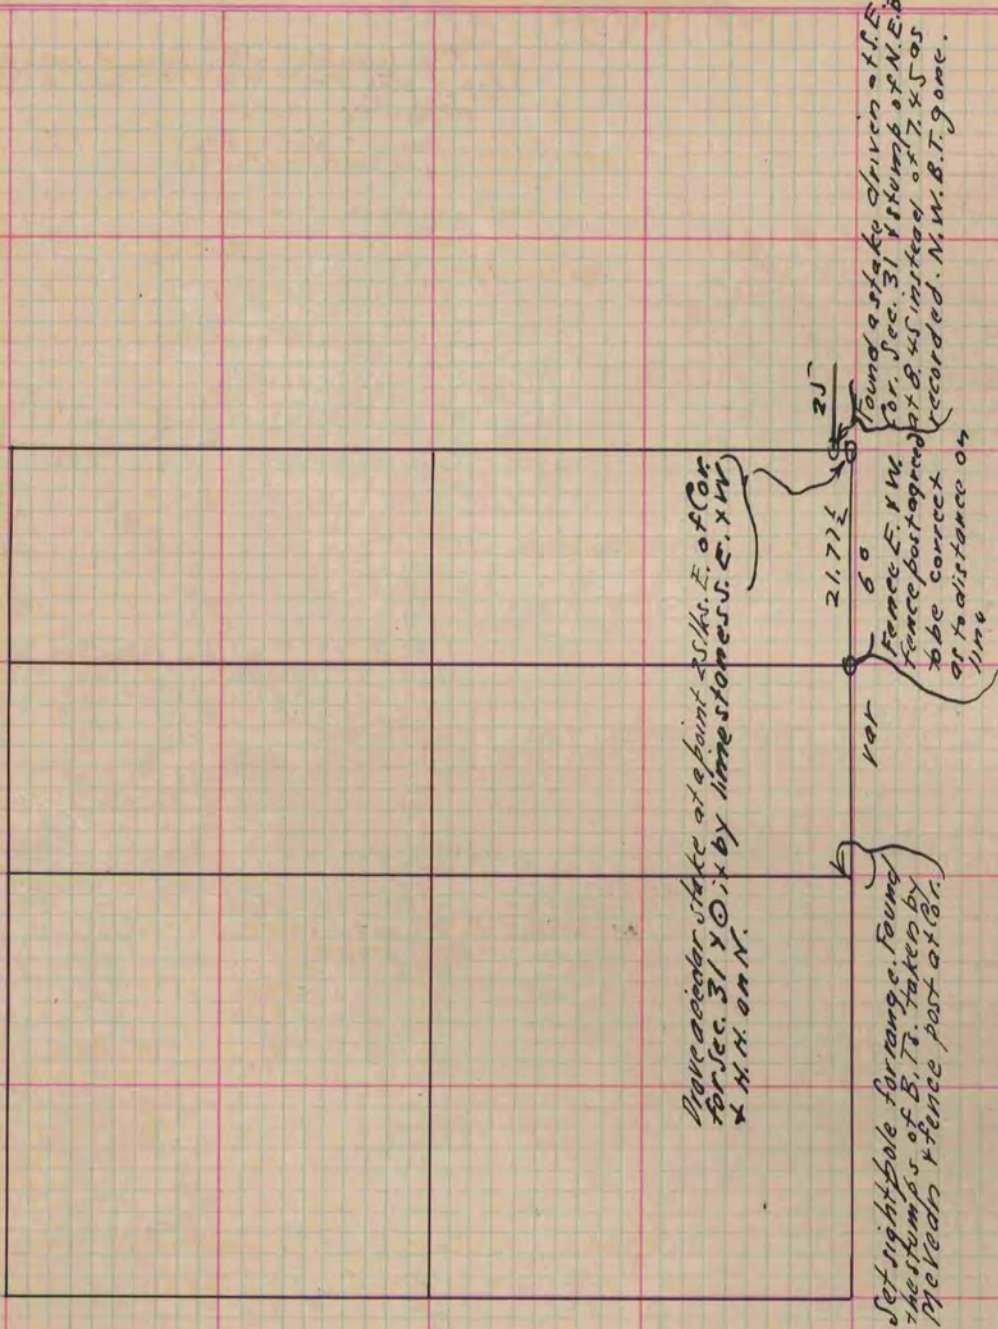

*Copied from P. 265 Vol. 2. County Surveyors Record.*