

MICROFILMED PLAT AND RECORD


117
✓-1

COUNTY BUILDING
CITY OF JAMESVILLE

Of a Survey on Section 31 T 3 R 13 E. of the 4 P. M. in Harmony Township
Rock County, Wisconsin, made November the 18th 1859

I hereby certify that the following is a correct record of said survey as made by me.

(Signed) Edward Ruger
R.H.B. County Surveyor.

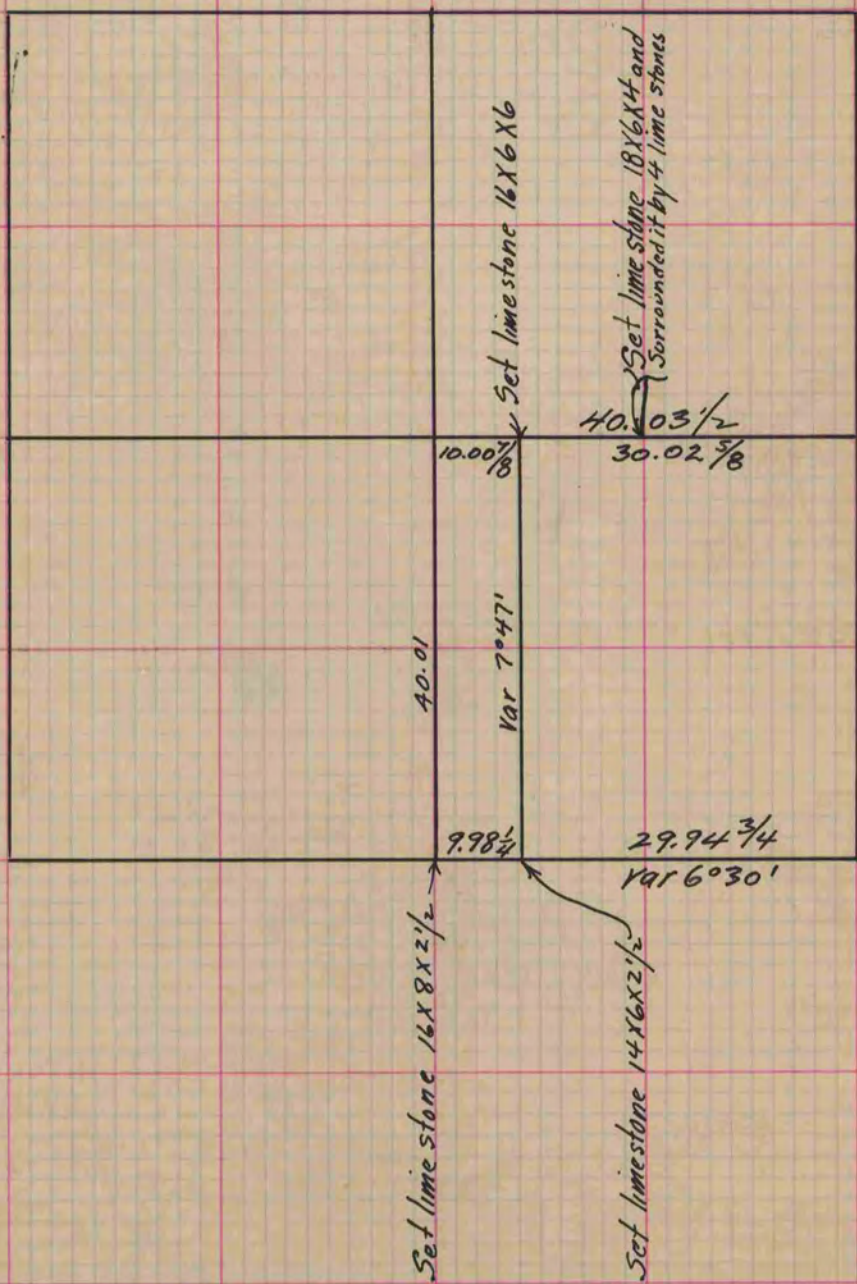

Copied from Page 126 Vol. 1. Original County Surveyors Record