

MICROFILMED PLAT AND RECORD

Of a Survey on Section 31 T 3 R 13 E. of the 4 P. M. in Harmony Township


Rock County, Wisconsin, made November the 23rd 1859

I hereby certify that the following is a correct record of said survey as made by me.

COUNTY BUILDING
CITY OF JANESVILLE

County Surveyor.

A record and plat of a Survey made in retracing that part of the shown on the plat between A & B. Variations marked on the

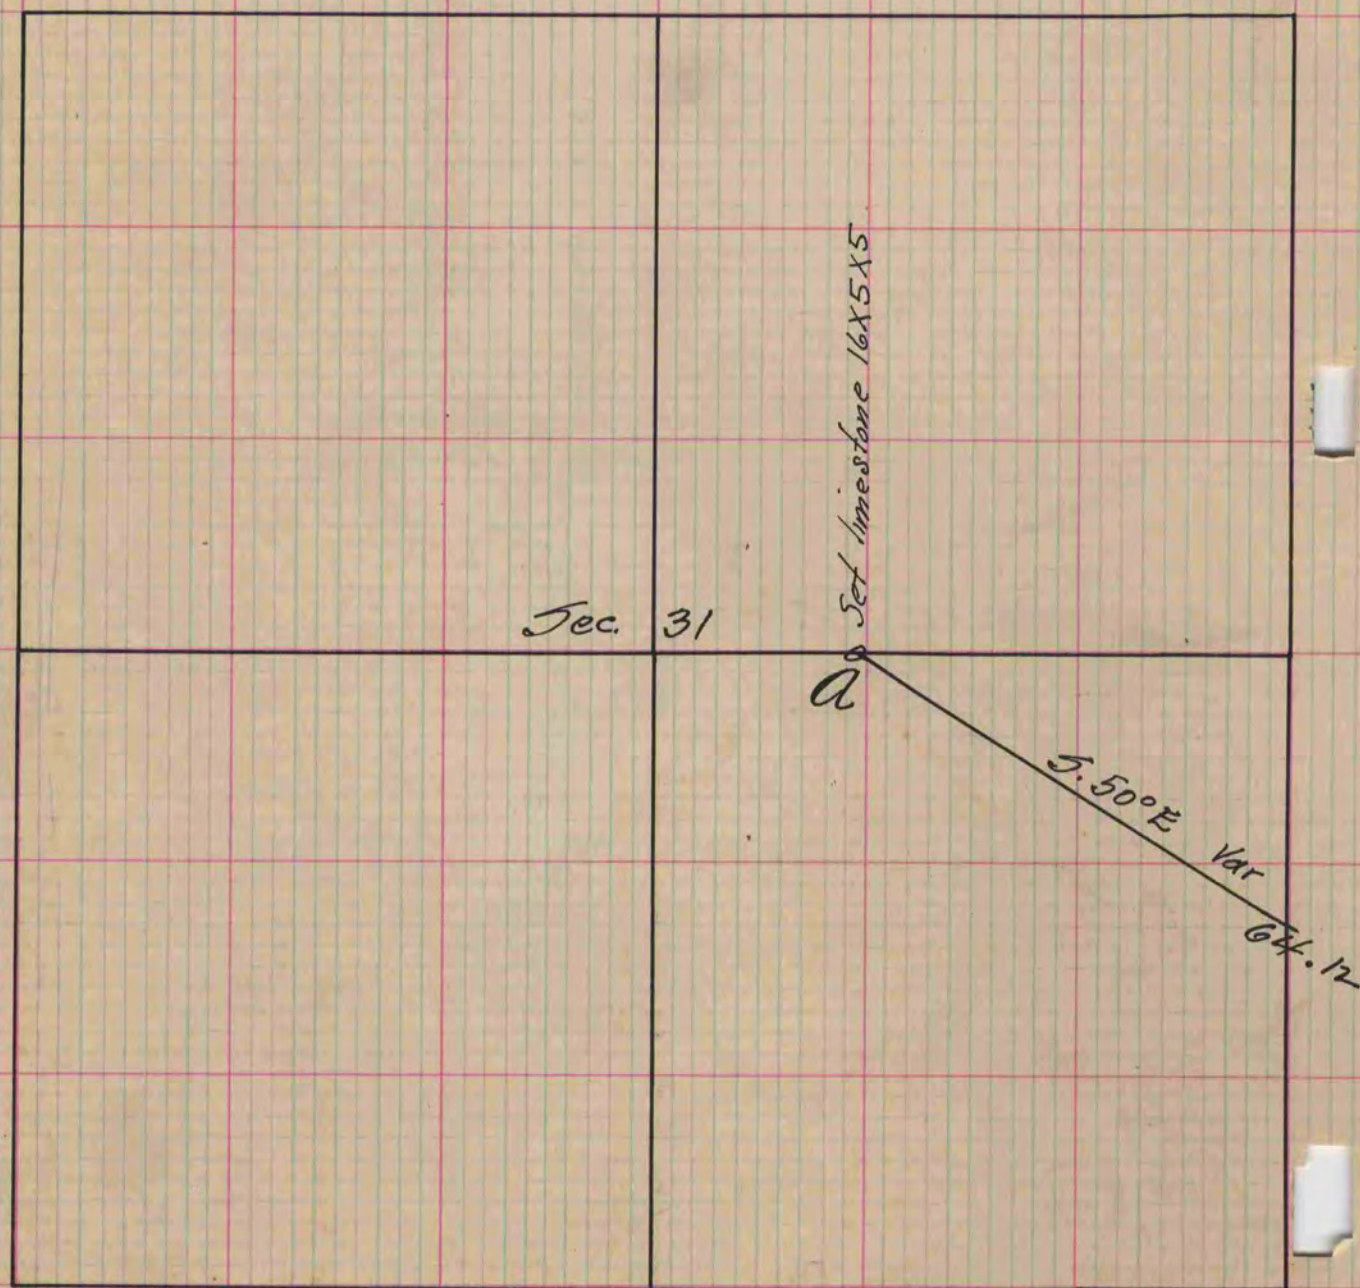

Copied from pages 127 and 128 Volume One