

MICROFILMED

# PLAT AND RECORD

81

V-1

COUNTY BUILDING  
CITY OF JANESVILLE

Of a Survey on Section 3 T 1 R 12 E. of the 4 P. M. in Beloit Township

Rock County, Wisconsin, made June the 11<sup>th</sup> 1858

I hereby certify that the following is a correct record of said survey as made by me.

(Signed) Joseph Church  
R.H.B. County Surveyor.

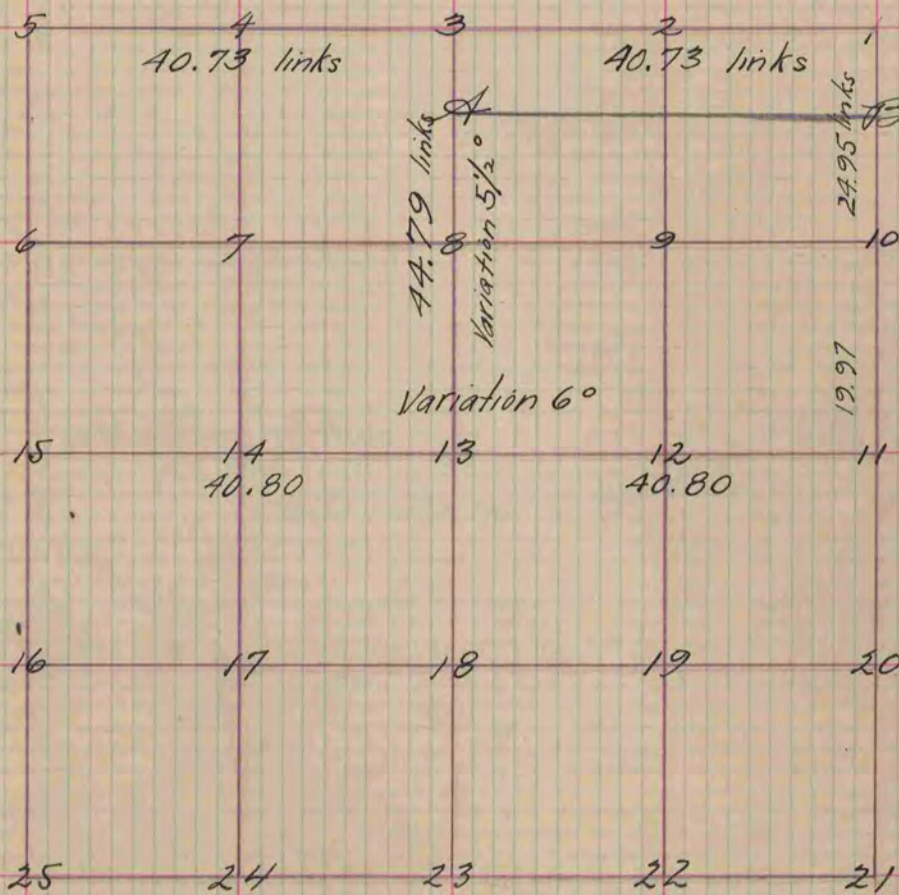


Fig. 12 Stake Marked no bearings  
 " 18 " " " "  
 " 11 " " " "  
 Letter A & B. Stake marked no bearings.

Copied from Page 82 Vol. One Original County Surveyors Record