

MICROFILMED

PLAT AND RECORD

109
V-7


COUNTY BUILDING
CITY OF JANESVILLE

Of a Survey on Section 36 T 1 R 13 E. of the 4 P. M. in Turtle Township

Rock County, Wisconsin, made June the 4th 1859

I hereby certify that the following is a correct record of said survey as made by me.

(Signed) E. F. Hobart Deputy
R.M.D. County Surveyor.

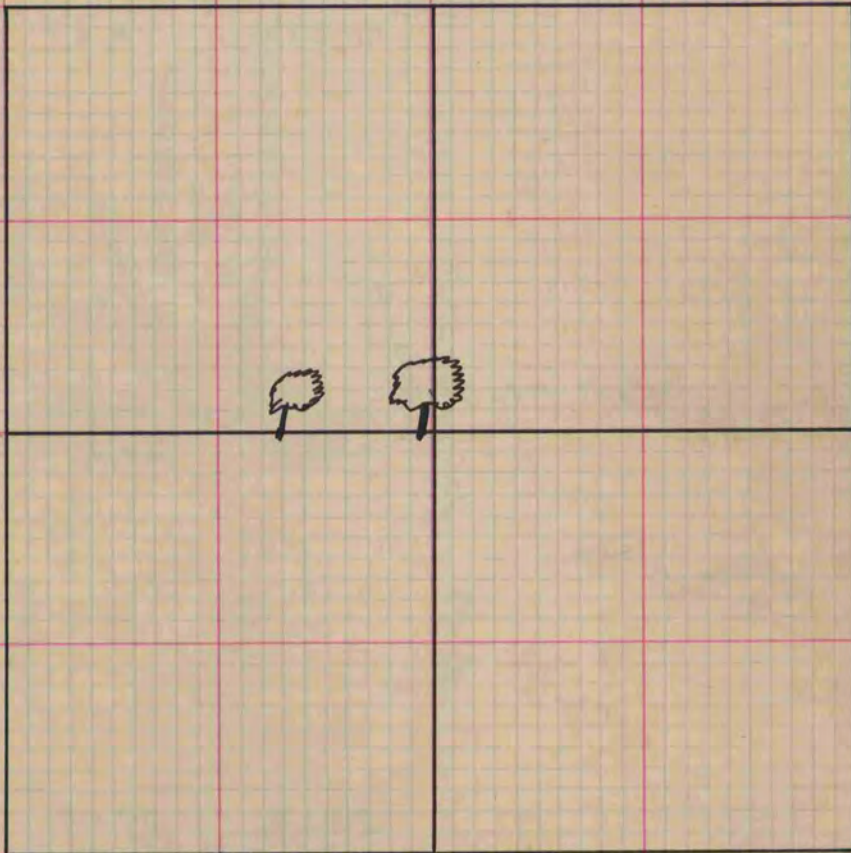

The E & W. Gr. line at a point 2453 links E. of W. Gr. post
 is 1 foot S. of centre of a Br. O. 16 inch. diameter
 E. & W. Gr. line at a point 3974 links E. of W. Gr. post
 is 24 1/2 links N of a Br. O 16 in diam.

Copied from Page 118 Vol. 1. Original County Surveyors Record