

V-MICROFILMED

# PLAT AND RECORD


Of a Survey on Section 31 T 3 R 12 E. of the 4 P. M. in Janesville Township  
Rock County, Wisconsin, made August the 29<sup>th</sup> 1859

I hereby certify that the following is a correct record of said survey as made by me.

COUNTY BUILDING  
CITY OF JANESVILLE

(Signed) Edward Ruger  
R.H.B.

County Surveyor.

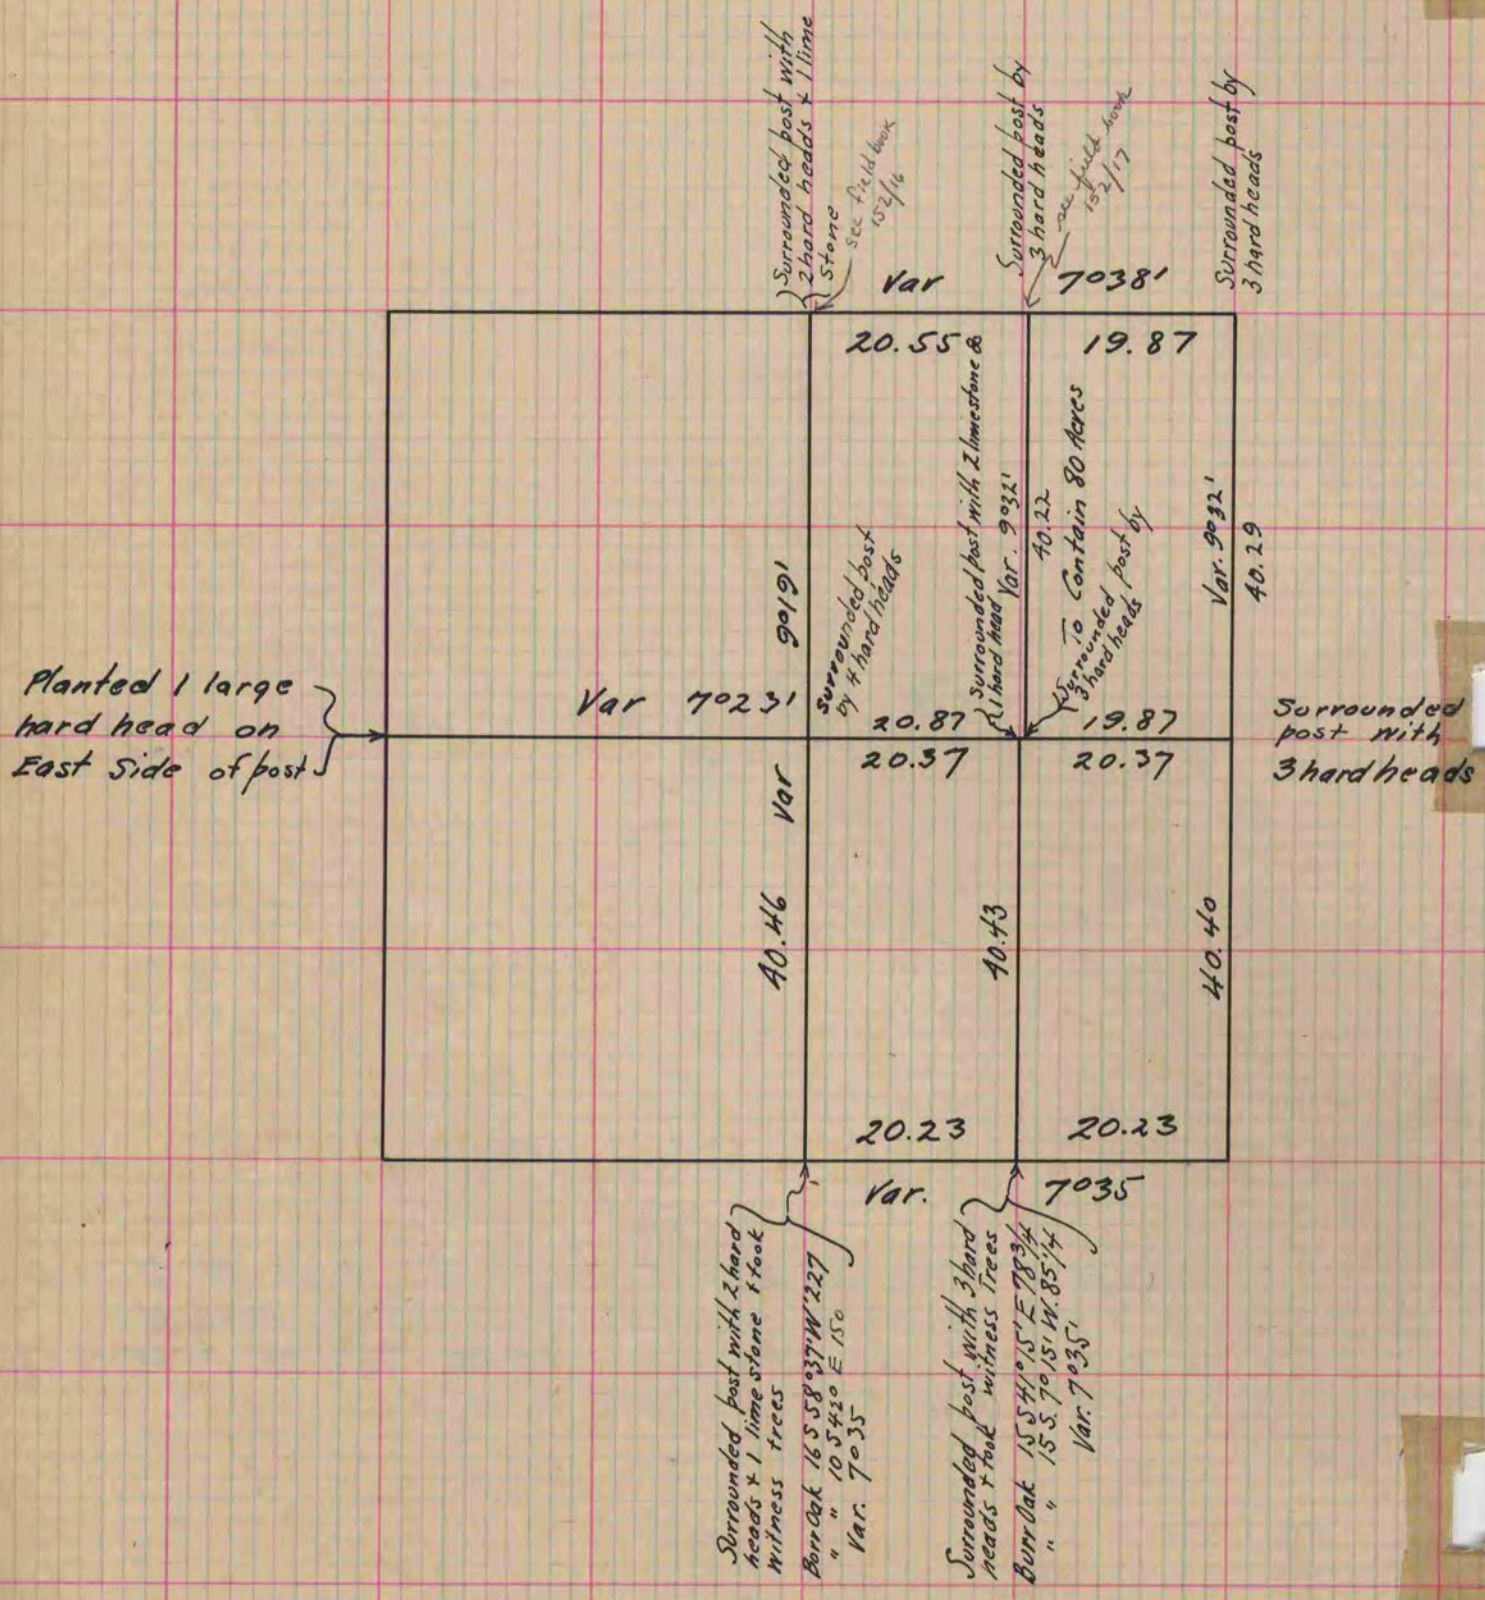

Copied from Page 119 Vol. 1. Original County Surveyors Record.