

# PLAT AND RECORD

VOL. 6

Of a Survey on Section 10, 13, 14 T 1 R 14 E. of the 4 P. M. in

Rock County, Wisconsin, made NOV the

hereby certify that the following is a correct record of said survey as made by me


COUNTY BUILDING  
CITY OF JANESVILLE

GLINTON  
WISCONSIN 530  
DONALD A. BARNES  
S-1216  
JANESVILLE  
WI. County Surveyor.

LAND SURVEYOR

SW COR SEC 14


DUG & FOUND 10" X 6" X 6" LIMESTONE, 2.5' DEEP, REPLACED WITH ALUM MON

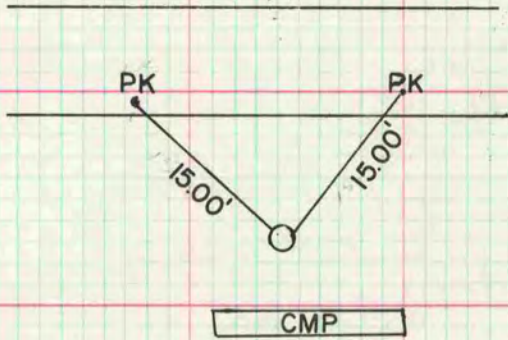

MICROFILMED

E 1/4 COR SEC 13

FOUND R/R SPIKE

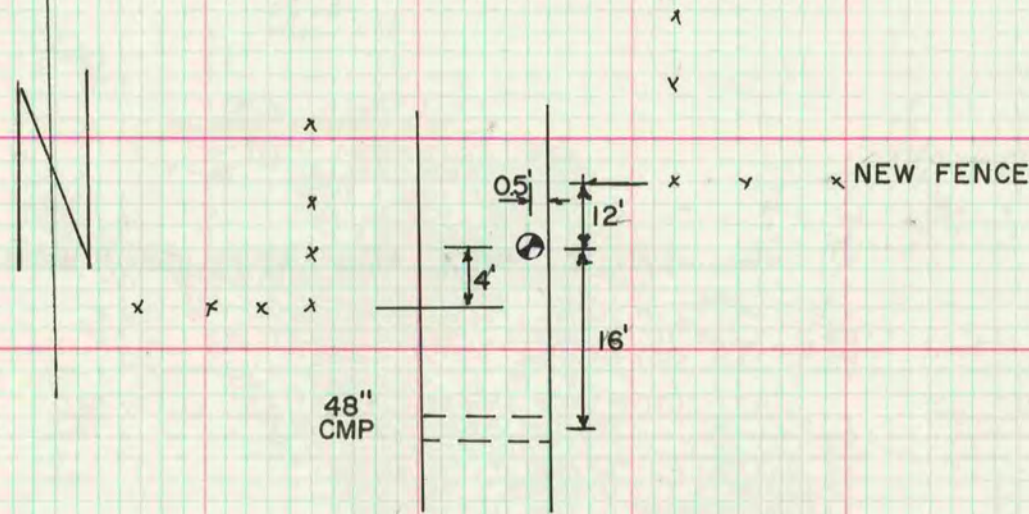

CENTER OF SEC 10

DUG & FOUND STAKE, SURROUNDED BY STONES. REPLACED WITH ALUM MON

48" OAK THAT WAS STRUCK BY LIGHTNING

