

PLAT AND RECORD

VOL. 6

17,

18,30 T

R. 2

14

E. of the 4 P. M. in

BRADFORD Township

Of a Survey on Section 18,30 T 2 R 14 E. of the 4 P. M. in Bradford Township

Rock County, Wisconsin, made

MARCH

the

23 1981

I hereby certify that the following is a correct record of said survey as made by me.

COUNTY BUILDING
CITY OF JANESVILLE

Donald Barnes



County Surveyor.

S 1/4 COR SEC 30

FOUND STONE IN MON BOX 4' EAST OF ROAD CENTER LINE

W 1/4 COR SEC 30


FOUND TOP 1 1/2' OF CUT LIMESTONE PAINTED ON E/W FENCE, 2.5' WEST OF N/S FENCE. SET CARSONITE POST.

E 1/4 COR SEC 18

FOUND MON BOX

CENTER 1/4 COR SEC 17

FOUND 3/8" x 6" PIPE & CHECKED WITH ALL 3 RECORD TIES. REPLACED IRON PIPE WITH ALUM MON.

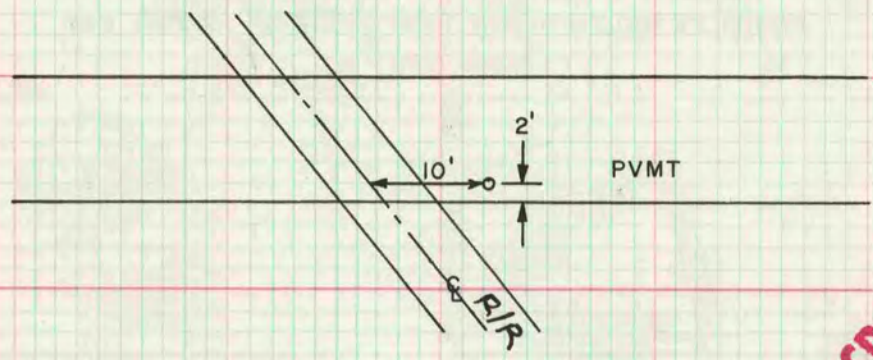

MICROFILMED

E 1/4 COR SEC 17

REPLACED 1 1/4" x 36" IRON PIPE WITH ALUM MON

N 1/4 COR SEC 17

FOUND STATE OF WI. DEPT. OF TRANSPORTATION MON, CAP IN CONC. SET CARSONITE POST