

VOL. 6 PLAT AND RECORD

Of a Survey on Section 1, 3, 11 T 1 R 14 E. of the 4 P. M. in _____ Township

Rock County, Wisconsin, made NOV the _____

I hereby certify that the following is a correct record of said survey as made by me

COUNTY BUILDING
CITY OF JAMESVILLE

CLINTON
6 WISCONSIN 80
DONALD A. BARNES
S-1216
JAMESVILLE
WI. County Surveyor.

Donald Barnes


LAND SURVEYOR

E 1/4 COR SEC 1

SET ALUM MON ON LINE WITH NE & SE CORNERS OF SEC 1 AT SINGLE PROPORTIONATE DISTANCE.

FORMER COUNTY SURVEYOR DUG & FOUND NOTHING.

○-3/8" X 33" BOLT

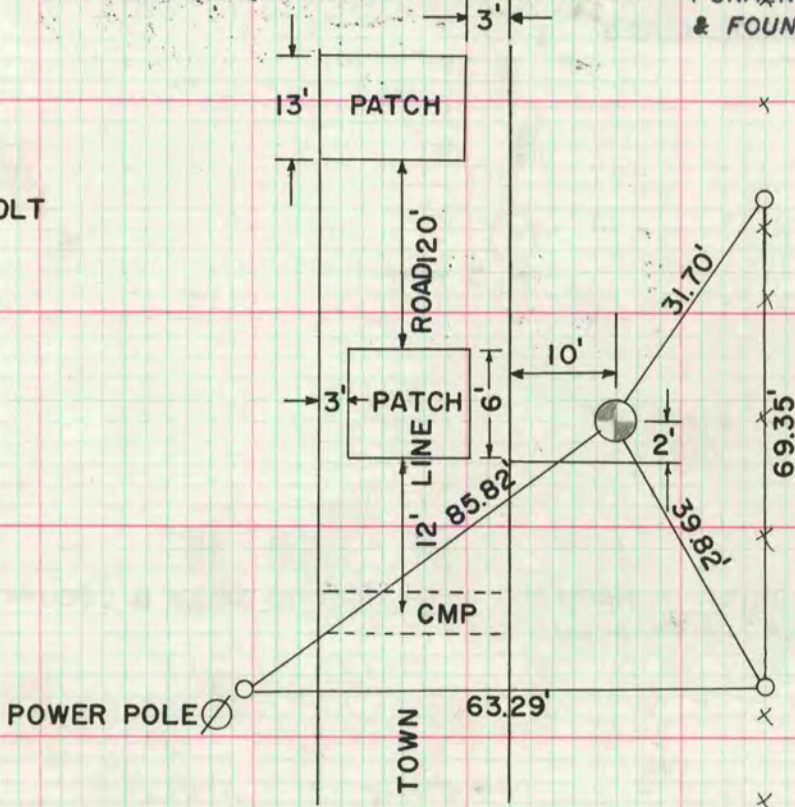


MICROFILMED

S 1/4 COR SEC 3

FOUND CONCRETE MONUMENT BROKE, REPLACED WITH ALUM MON.

N 1/4 COR SEC 11

FOUND RUSTED OUT 1 1/2" IRON PIPE REPLACED WITH ALUM MON.

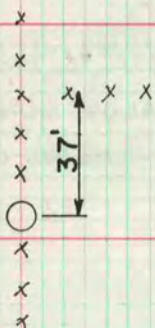

W 1/4 COR SEC 11

DUG & FOUND NOTHING, SET ALUM MON ON LINE WITH NW & SW CORNERS OF SEC 11 AT SINGLE PROPORTIONATE DISTANCE

