


PLAT AND RECORD VOL. 6 57

Of a Survey on Section 19, 34 T 1 R 14 E. of the 4 P. M. in CLINTON Township
 Rock County, Wisconsin, made JULY 1980

COUNTY BUILDING
 CITY OF JANESVILLE


I hereby certify that the following is a correct record of said survey as made by me.

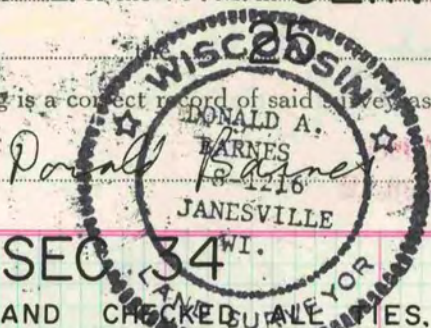

County Surveyor.


SE COR SEC 34

FOUND 1" PIPE OF RECORD AND CHECKED TIE LINES.
 TIE PIPES ALL DISTURBED. SET ALUMINUM MONUMENT,
 USED 3/8" x 32" IRON BOLT AS REFERENCE MARKERS,
 7-25-80 CORNER IN LINE WITH OLD FENCE,

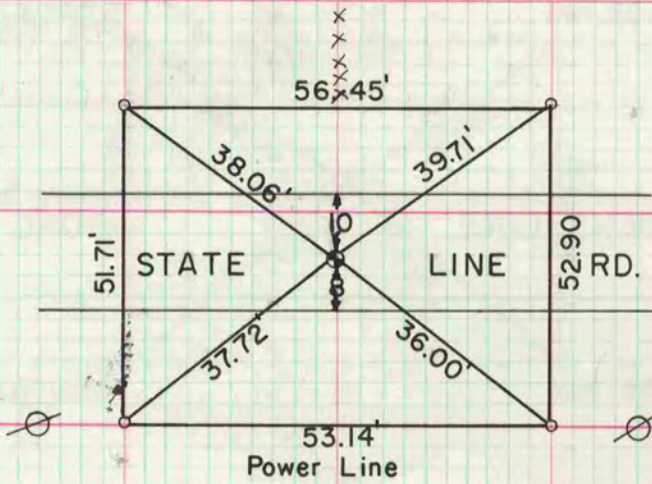

SE COR SEC 19

FOUND 1" IRON PIPES AND HARD HEAD
 SET ALUMINUM MONUMENT 7-25-80
 PIPE OF RECORD DRIVEN DOWN TO PLACE MONUMENT TOP.

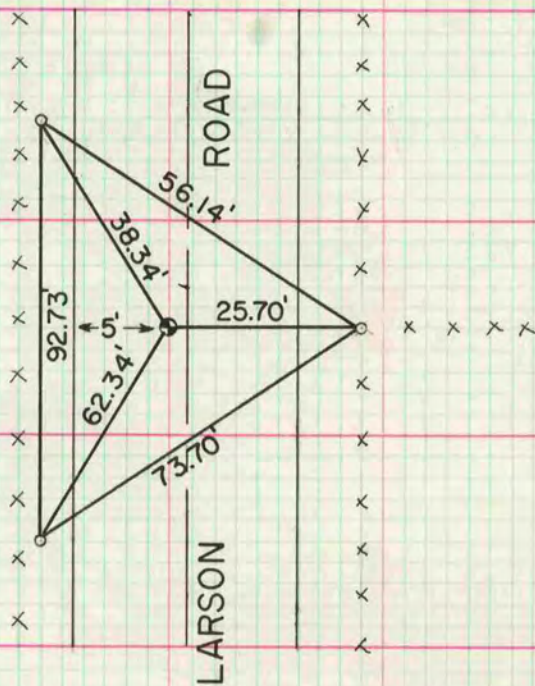

MICROFILMED

o 1" IP