


Of a Survey on Section 12 T. 1 R. 14 E. of the 4 P. M. in CLINTON Township  
Rock County, Wisconsin, made NOV. 7th 1980

I hereby certify that the following is a correct as made by me.

COUNTY BUILDING  
CITY OF JANESVILLE

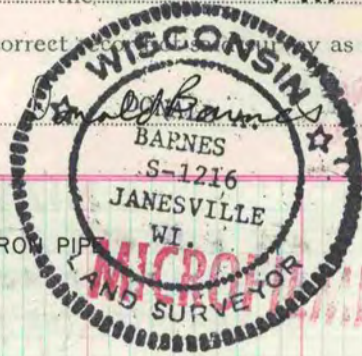

County Surveyor.

THE GEO. D. BARNARD COMPANY, ST. LOUIS

ASSUMED NORTH

