

# PLAT AND RECORD

COUNTY BUILDING  
CITY OF JANESVILLE

REC 12/8/75 DAB

Of a Survey on Section 25 T 2 R 11 E. of the 4 P. M. in PLYMOUTH Township

Rock County, Wisconsin, made JULY the 25 19 62


I hereby certify that the following is a correct record of said survey as made by me.

*R. W. Atkinson*

County Surveyor.

**MICROFILMED**

THE GEO. D. BARNARD COMPANY, ST. LOUIS

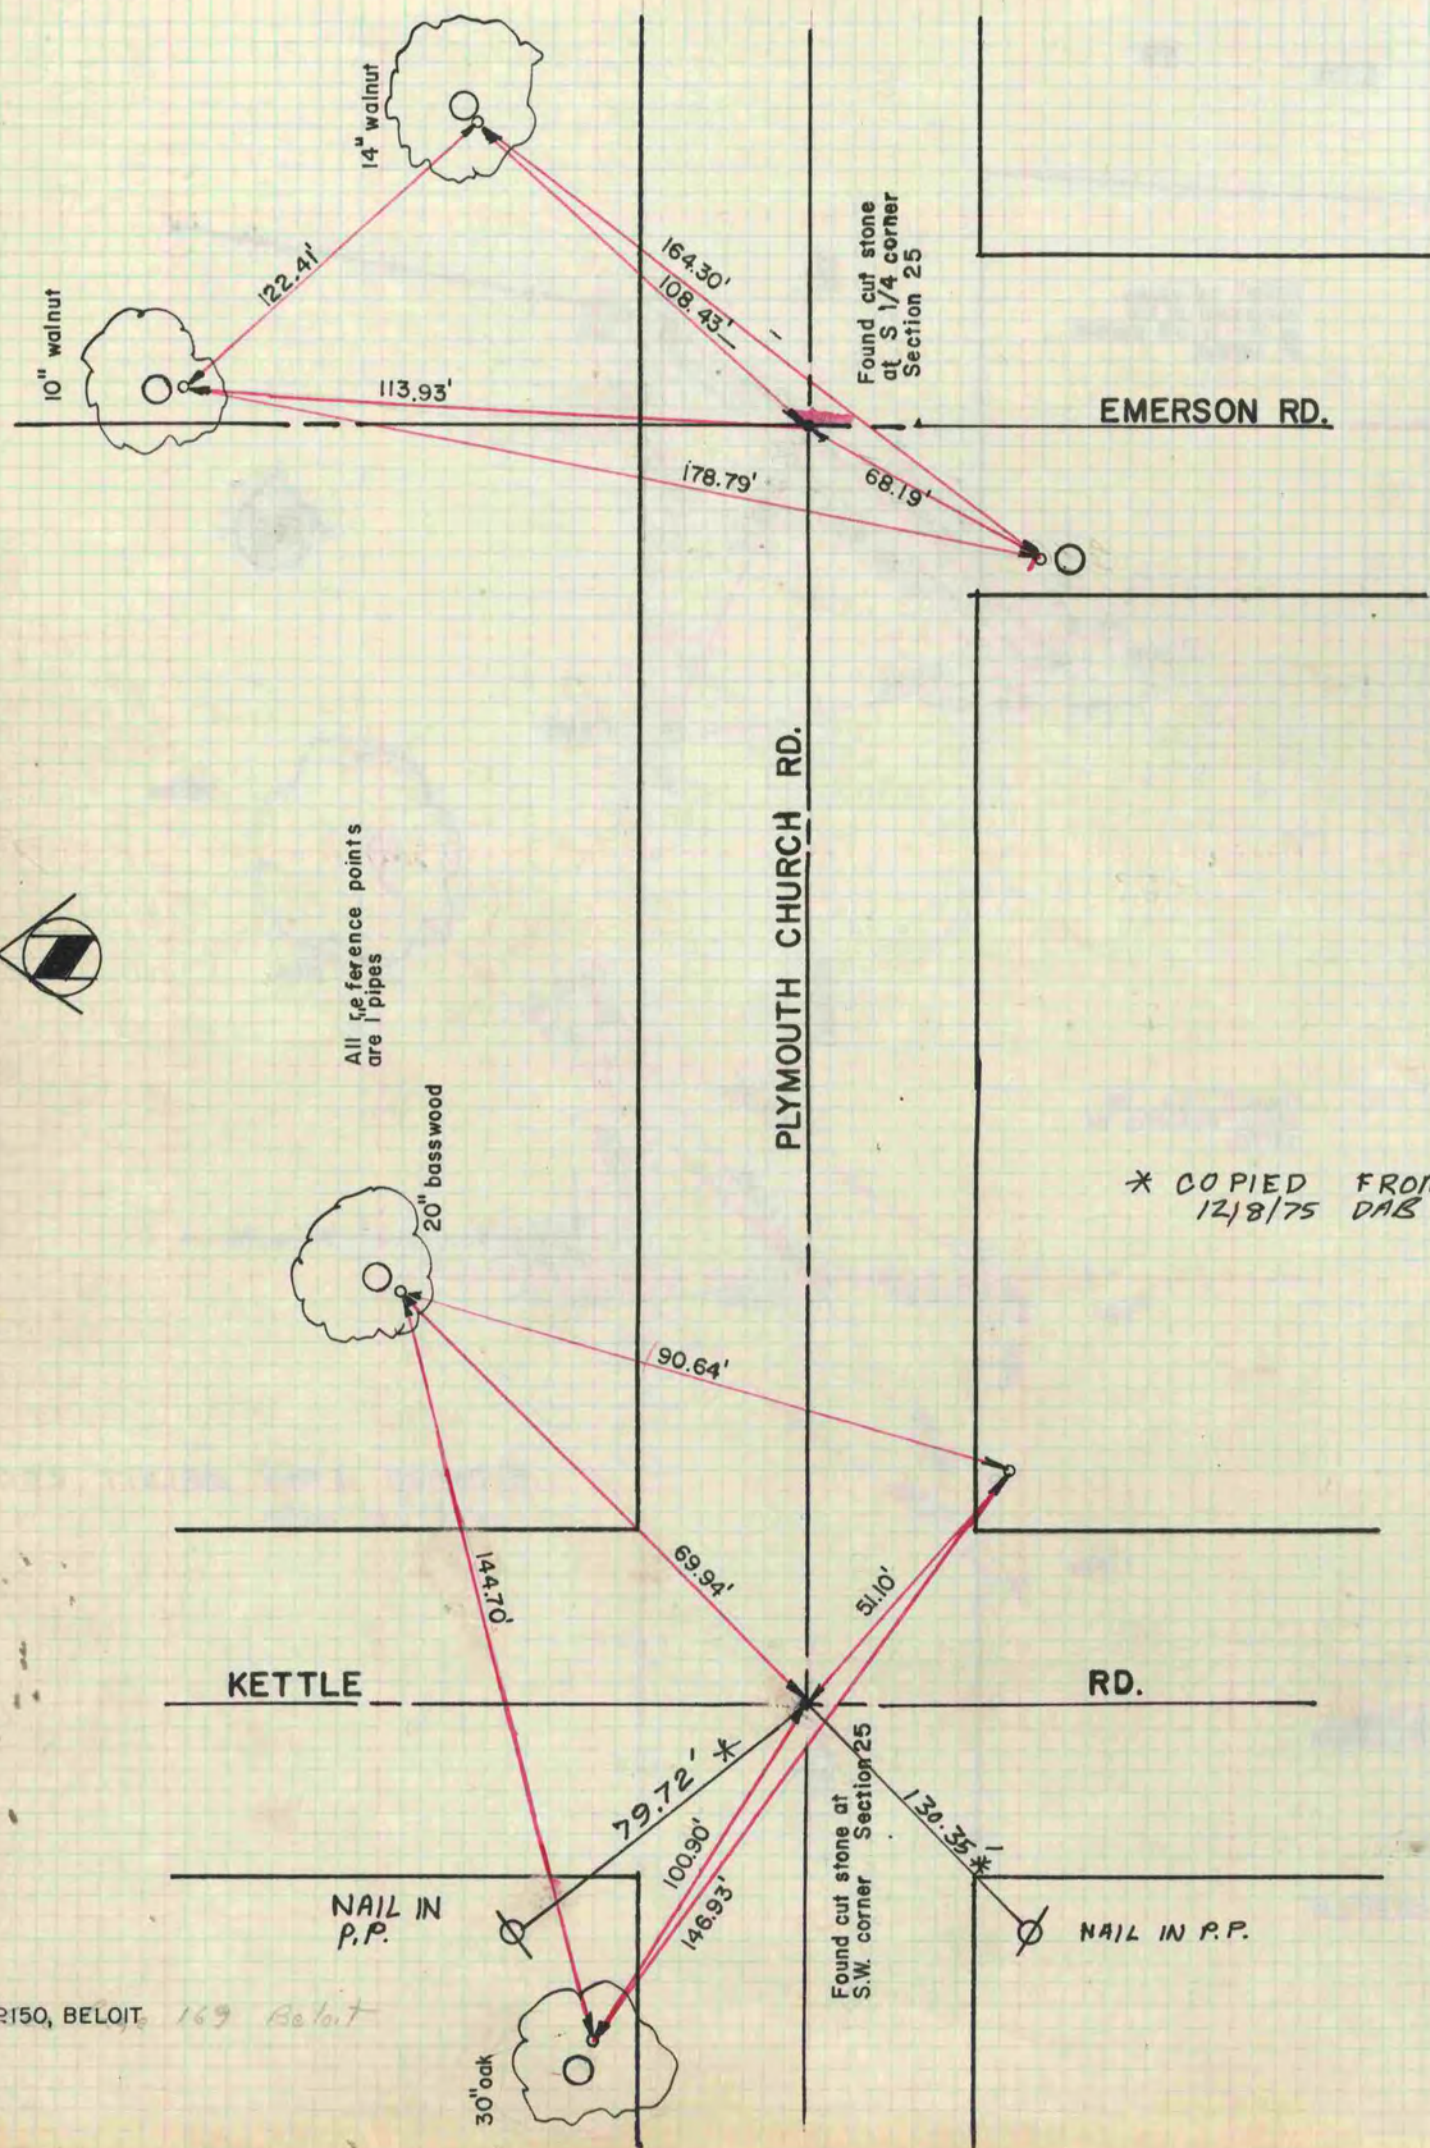

R150, BELOIT, 169 Beloit