


# PLAT AND RECORD

Of a Survey on Section 18, 19 T 3 R 14 E. of the 4 P. M. JOHNSTOWN Township  
Rock County, Wisconsin, made JULY the \_\_\_\_\_


I hereby certify that the following is a correct record of said survey as made by me.

COUNTY BUILDING  
CITY OF JANESVILLE

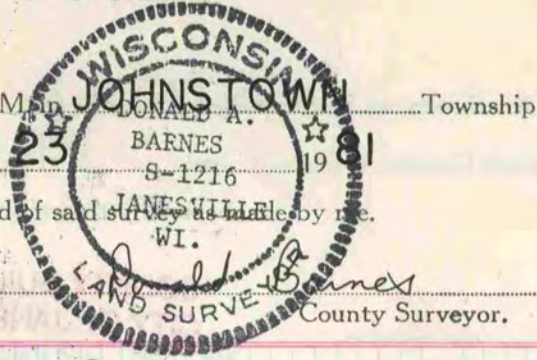

## NW COR. SEC. 19

FD. PK — SET ALUM. MON.

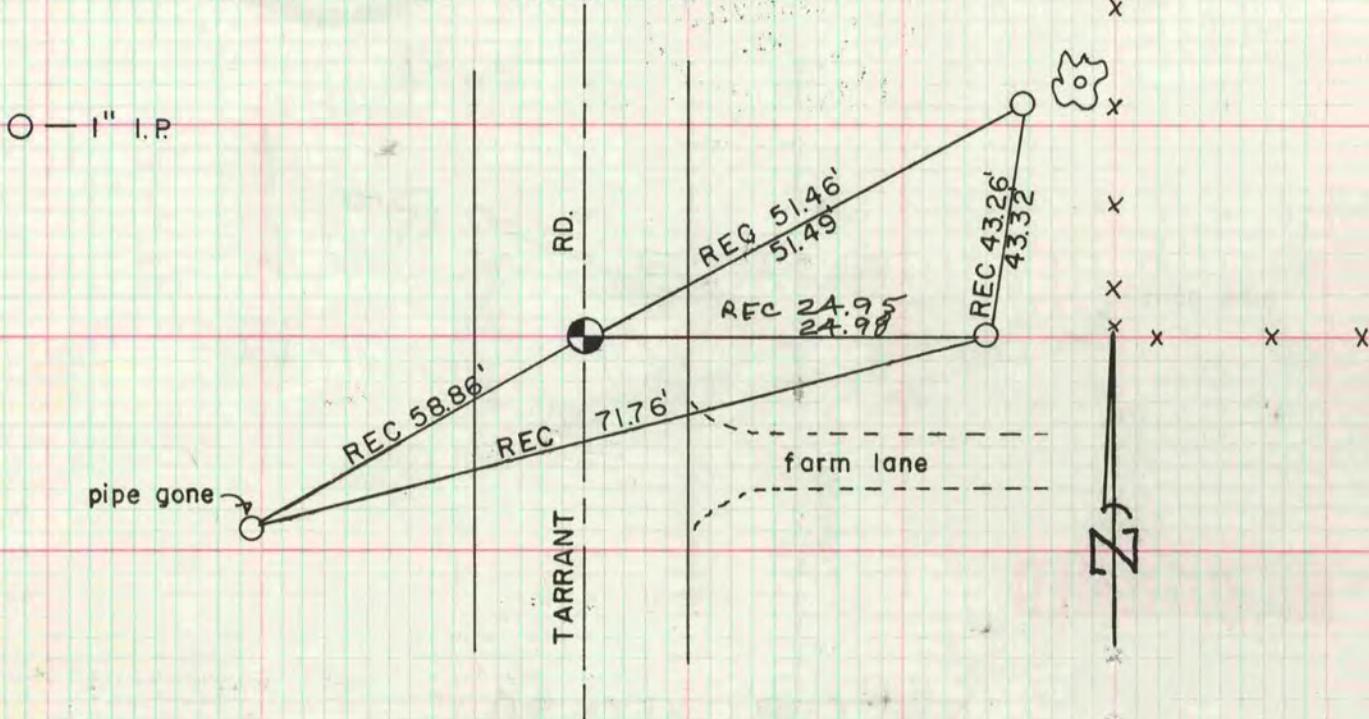

## W 1/4 COR. SEC. 18

FOUND PK — SET ALUM. MON.

