

# PLAT AND RECORD

VOL. 6

Of a Survey on Section 1, 10 T 1 R 10 E. of the 4 P. M. in AVON Township

Rock County, Wisconsin, made

APRIL

the 20th 1981

I hereby certify that the following is a correct record of said survey as made by me.


COUNTY BUILDING  
CITY OF JANESVILLE



County Surveyor.

## E 1/4 COR SEC 10

DUG & FOUND NOTHING. OCCUPATION IS IN HARMONY WITH RECORD DISTANCES TO THE NORTH AND WEST. SET ALUM MONUMENT AT FENCE INTERSECTION.

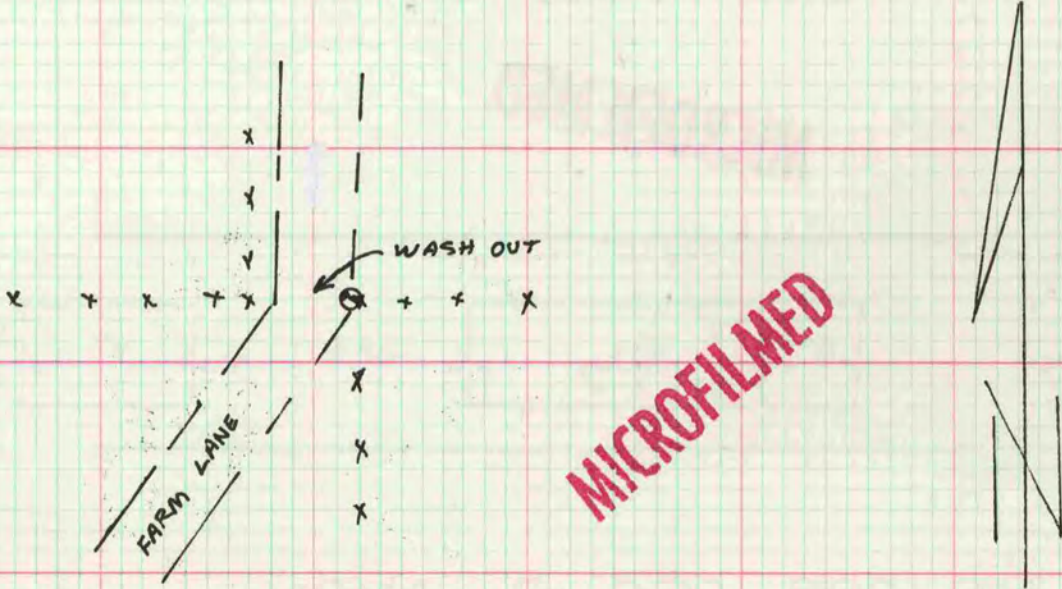

**MICROFILMED**

## SE COR SEC 1

DUG 10' DEEP AND FOUND NOTHING.

