

# PLAT AND RECORD

169

VOL. 6

31, 32, 33, 34

Of a Survey on Section T 1 R 10 E. of the 4 P. M. in AVON Township


Rock County, Wisconsin, made MAY 19 81

I hereby certify that the following is a correct and true copy of said survey as made by me



COUNTY BUILDING CITY OF JANESVILLE County Surveyor.

BM S16° 09' 31" W 38.92 OF THE NE CORNER OF SEC 21 T29N R10E

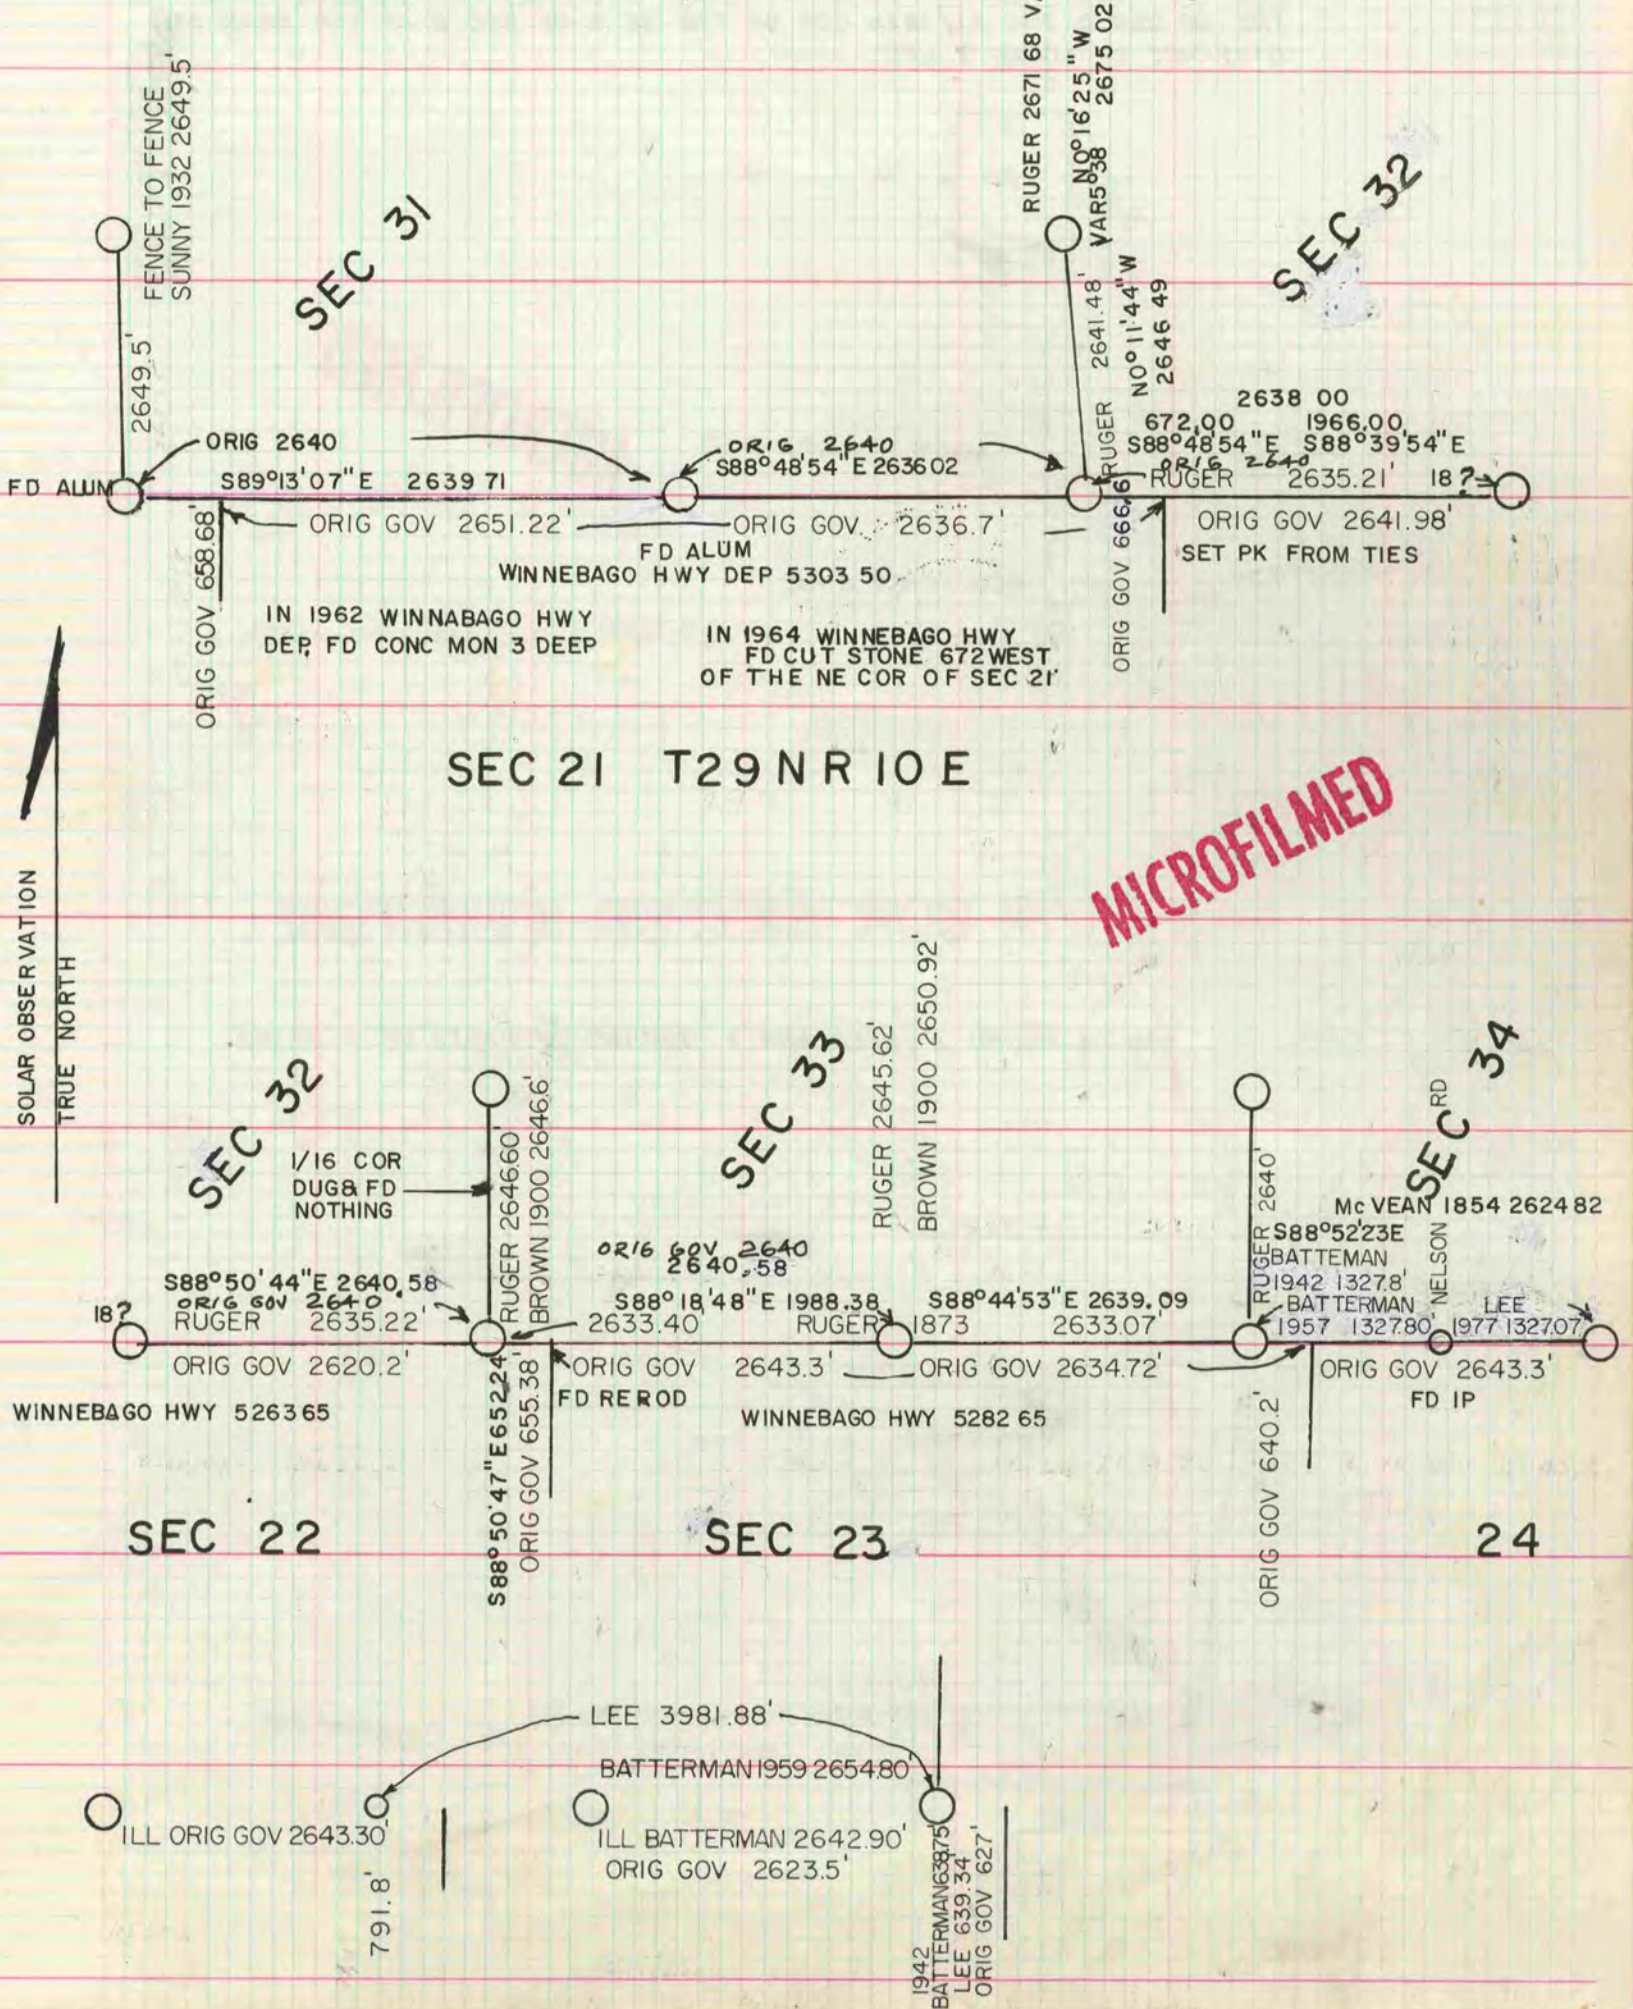

MICROFILMED