

PLAT AND RECORD

VOL. 6

Of a Survey on Section 17, 21 T 3 R 13 E. of the 4 P. M. in HARMONY Township

Rock County, Wisconsin, made NOV the


I hereby certify that the following is a correct record of said survey

COUNTY BUILDING
CITY OF JANESVILLE



S 1/4 COR SEC 21

SET ALUM MON ON LINE WITH PK TO THE EAST THE SE CORNER OF SECTION 21 AS PREVIOUSLY SHOWN. SEE VOL 6 PG 16

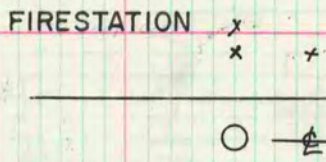

MICROFILMED

SW COR SEC 17

SET ALUM MON FROM TIES IN APARTMENT BUILDING

