

# VOL. 6 PLAT AND RECORD

Of a Survey on Section **12, 2, 3** T **1** R **14** E. of the 4 P. M. in **CLINTON** Township

Rock County, Wisconsin, made **NOV** the


I hereby certify that the following is a correct record of said survey as made by me

COUNTY BUILDING  
CITY OF JANESVILLE



## N 1/4 COR. SEC. 12


SET ALUM MON ON TOP OF LARGE HARDHEAD 2' ABOVE GROUND, BUILT MOUND OF DIRT & HARDHEADS. MONUMENT IS ON LINE WITH THE NE & NW CORNERS OF SEC 12 AT SINGLE PROPORTIONATE DISTANCE. H. LEE DID NOT FIND ANYTHING AT THE NE CORNER OF SEC 12. HE SET THE CORNER AND THEN SET THE N 1/4 CORNER. LATER THE WALWORTH COUNTY SURVEYOR DUG AND FOUND A CONCRETE MONUMENT AT THE NE CORNER OF SECTION 12. THIS WAS USED TO SET THE ALUM MON AT THE N 1/4 CORNER OF SECTION 12.

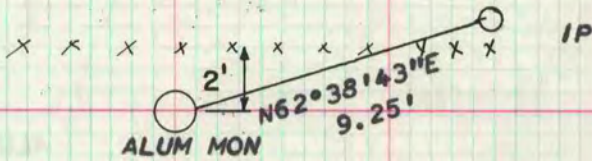

## W 1/4 COR. SEC 2

FOUND CONCRETE MONUMENT WITH BRASS CAP TIES FROM DEP. OF TRANSPORTATION DISTRICT 1

MICROFILMED

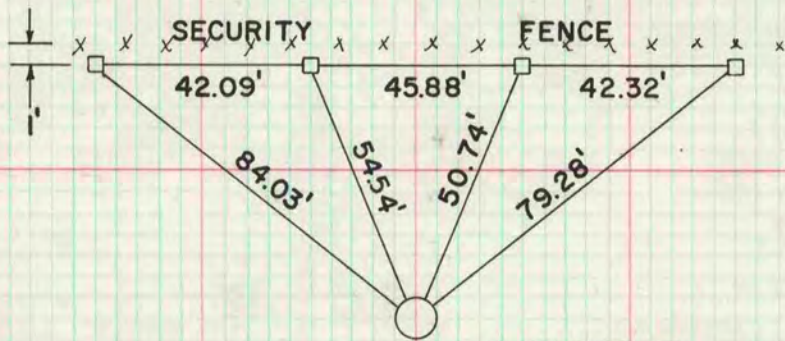

Y 210788.33  
X 2319061.77

## SW COR. SEC 2

FOUND CONCRETE MONUMENT 0.2' ABOVE GROUND.

