

VOL. 6 PLAT AND RECORD


Of a Survey on Section 15, 16 T 1 R 14 E. of the 4 P. M. in Clinton Township
Rock County, Wisconsin, made NOV the 10 19 80

I hereby certify that the following is a correct record of said survey as made by me.

COUNTY BUILDING
CITY OF JANESVILLE




SW COR
DUG & FOUND NOTHING, PROPORTIONATE
DISTANCE IS IN HARMONY WITH OCCUPATION.
SET ALUM MON.

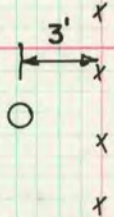

MICROFILMED

S 1/4 COR SEC 16
DUG & FOUND NOTHING, SET ALUM MON ON
LINE WITH SE & SW CORNERS OF SEC 16 AT
SINGLE PROPORTIONATE DISTANCE.

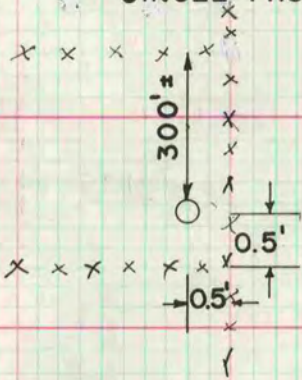

W 1/4 COR SEC 15
DUG & FOUND NOTHING, SET ALUM MON ON
LINE WITH THE NW & SW CORNERS OF SEC
15 AT SINGLE PROPORTIONATE DISTANCE

