

PLAT AND RECORD

Of a Survey on Section **29, 19** T **3** R **14** E. of the 4 P. M. in **JOHNSTOWN** Township

Rock County, Wisconsin, made **AUGUST** the **14**

I hereby certify that the following is a correct record of said survey as made by me



**COUNTY BUILDING
CITY OF JANESVILLE**



N 1/4 COR SEC 29 T3N R14E


FD PK NAIL ON ROAD SURFACE

X X X X X X X X X X

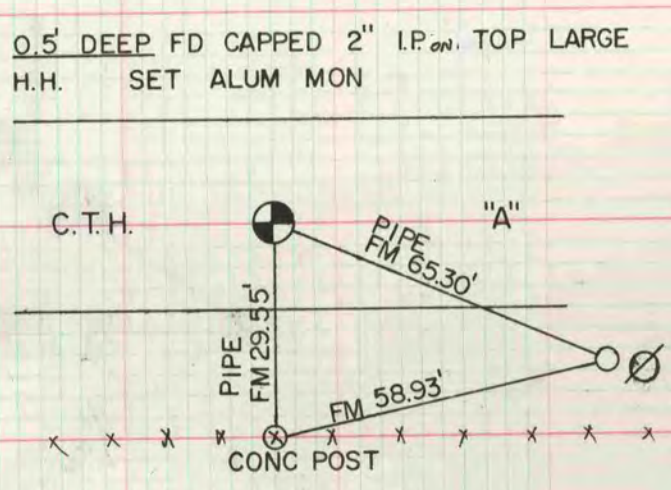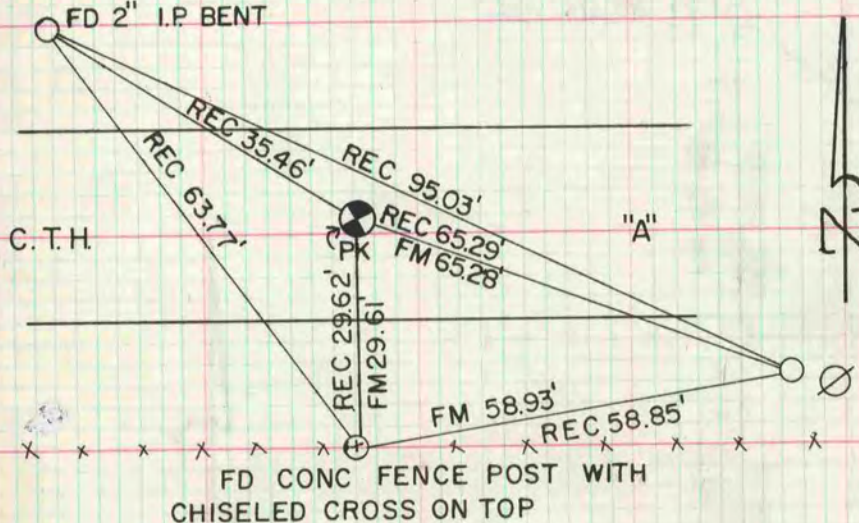

SE COR SEC 19

Fd 2" IP REPLACED WITH ALUM MON

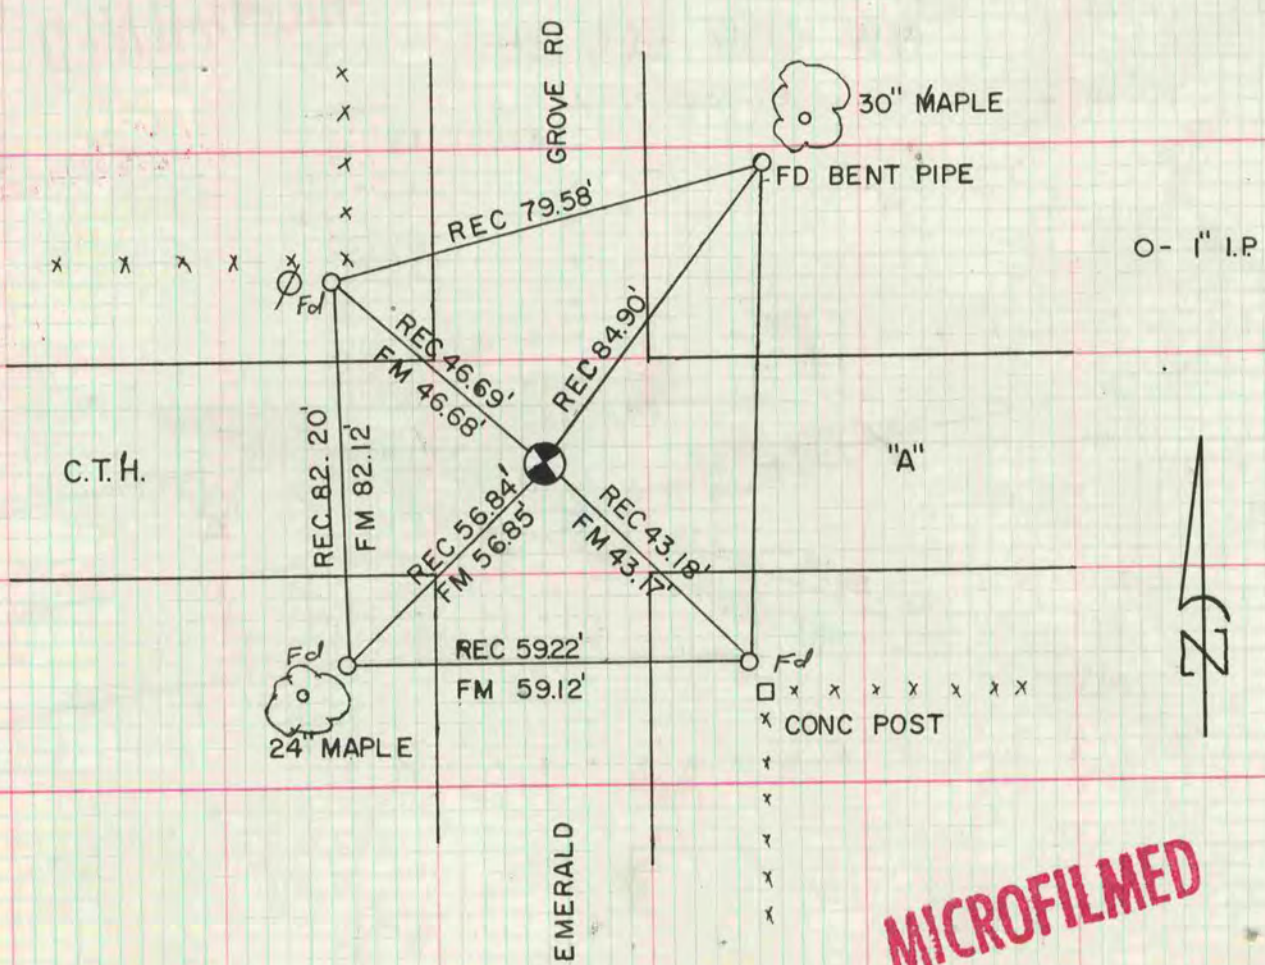

MICROFILMED