


PLAT AND RECORD

Of a Survey on Section **12** T **2** R **10** E. of the 4 P. M. in **SPRING VALLEY** Township
Rock County, Wisconsin, made **OCTOBER** the **19** 19**89**

**COUNTY BUILDING
CITY OF JANESVILLE**

I hereby certify that the following is a correct record of said survey as made by me.

Donald Barnes

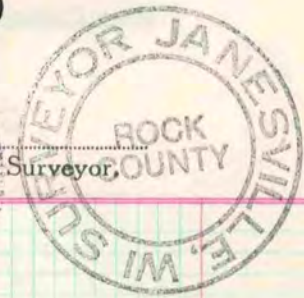


MICROFILMED

S86-46-11E 2698.22 PLACED ALUM RUGER 1870 2697.75
LOCKE 1867 2690.29 **N 1/4 COR** S86-46-11E 2698.22
LOCKE 1867 2690.29

PLACED ALUM
NE COR

**NW
COR**

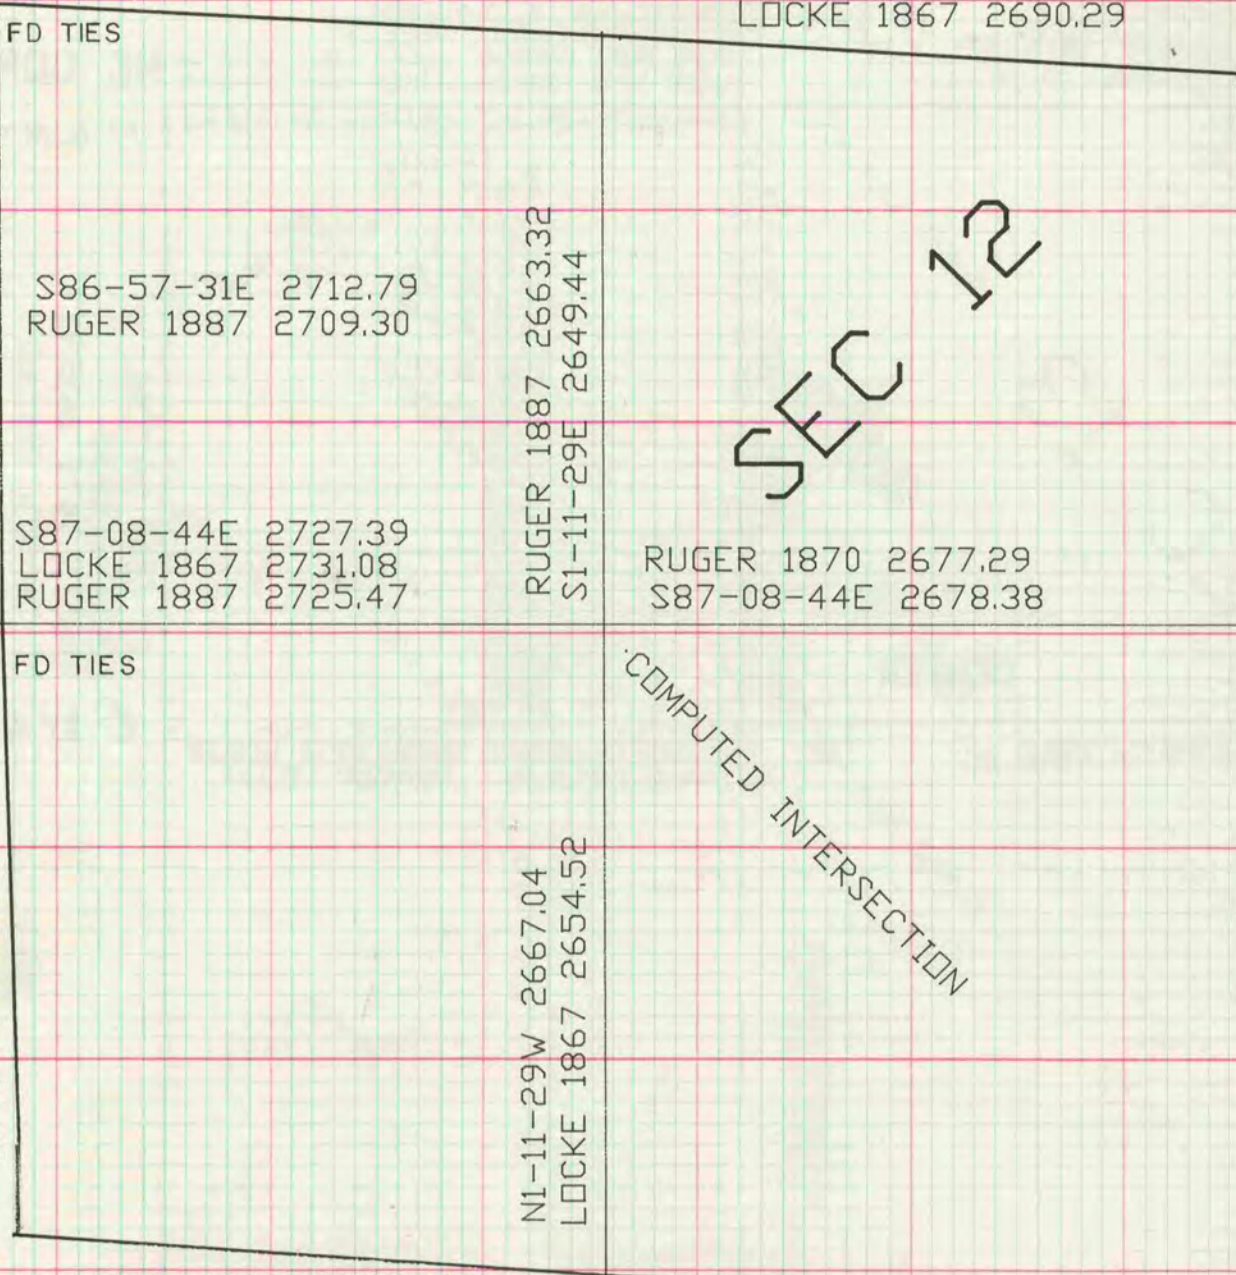

**NW
COR**

**W 1/4
COR**

**SE
COR**

LOCKE 1867 2693.46 **S 1/4 COR** S87-55-01E 2661.78
N86-35-42W 2698.14 PLACED POLY RUGER 1874 2657.16
LOCKE 1867 2657.16

FD ALUM
SE COR

FD ALUM

**W 1/4
COR**

**NW
COR**