

PLAT AND RECORD

CITY OF JANESVILLE
COUNTY BUILDING

COUNTY BUILDING
CITY OF JANESVILLE

Of a Survey on Section 8 T 1 R 11 E. of the 4 P. M. in NEWARK Township


Rock County, Wisconsin, made OCTOBER the 30 1970

I hereby certify that the following is a correct record of said survey as made by me.

MICROFILMED

Robert Frank

County Surveyor.

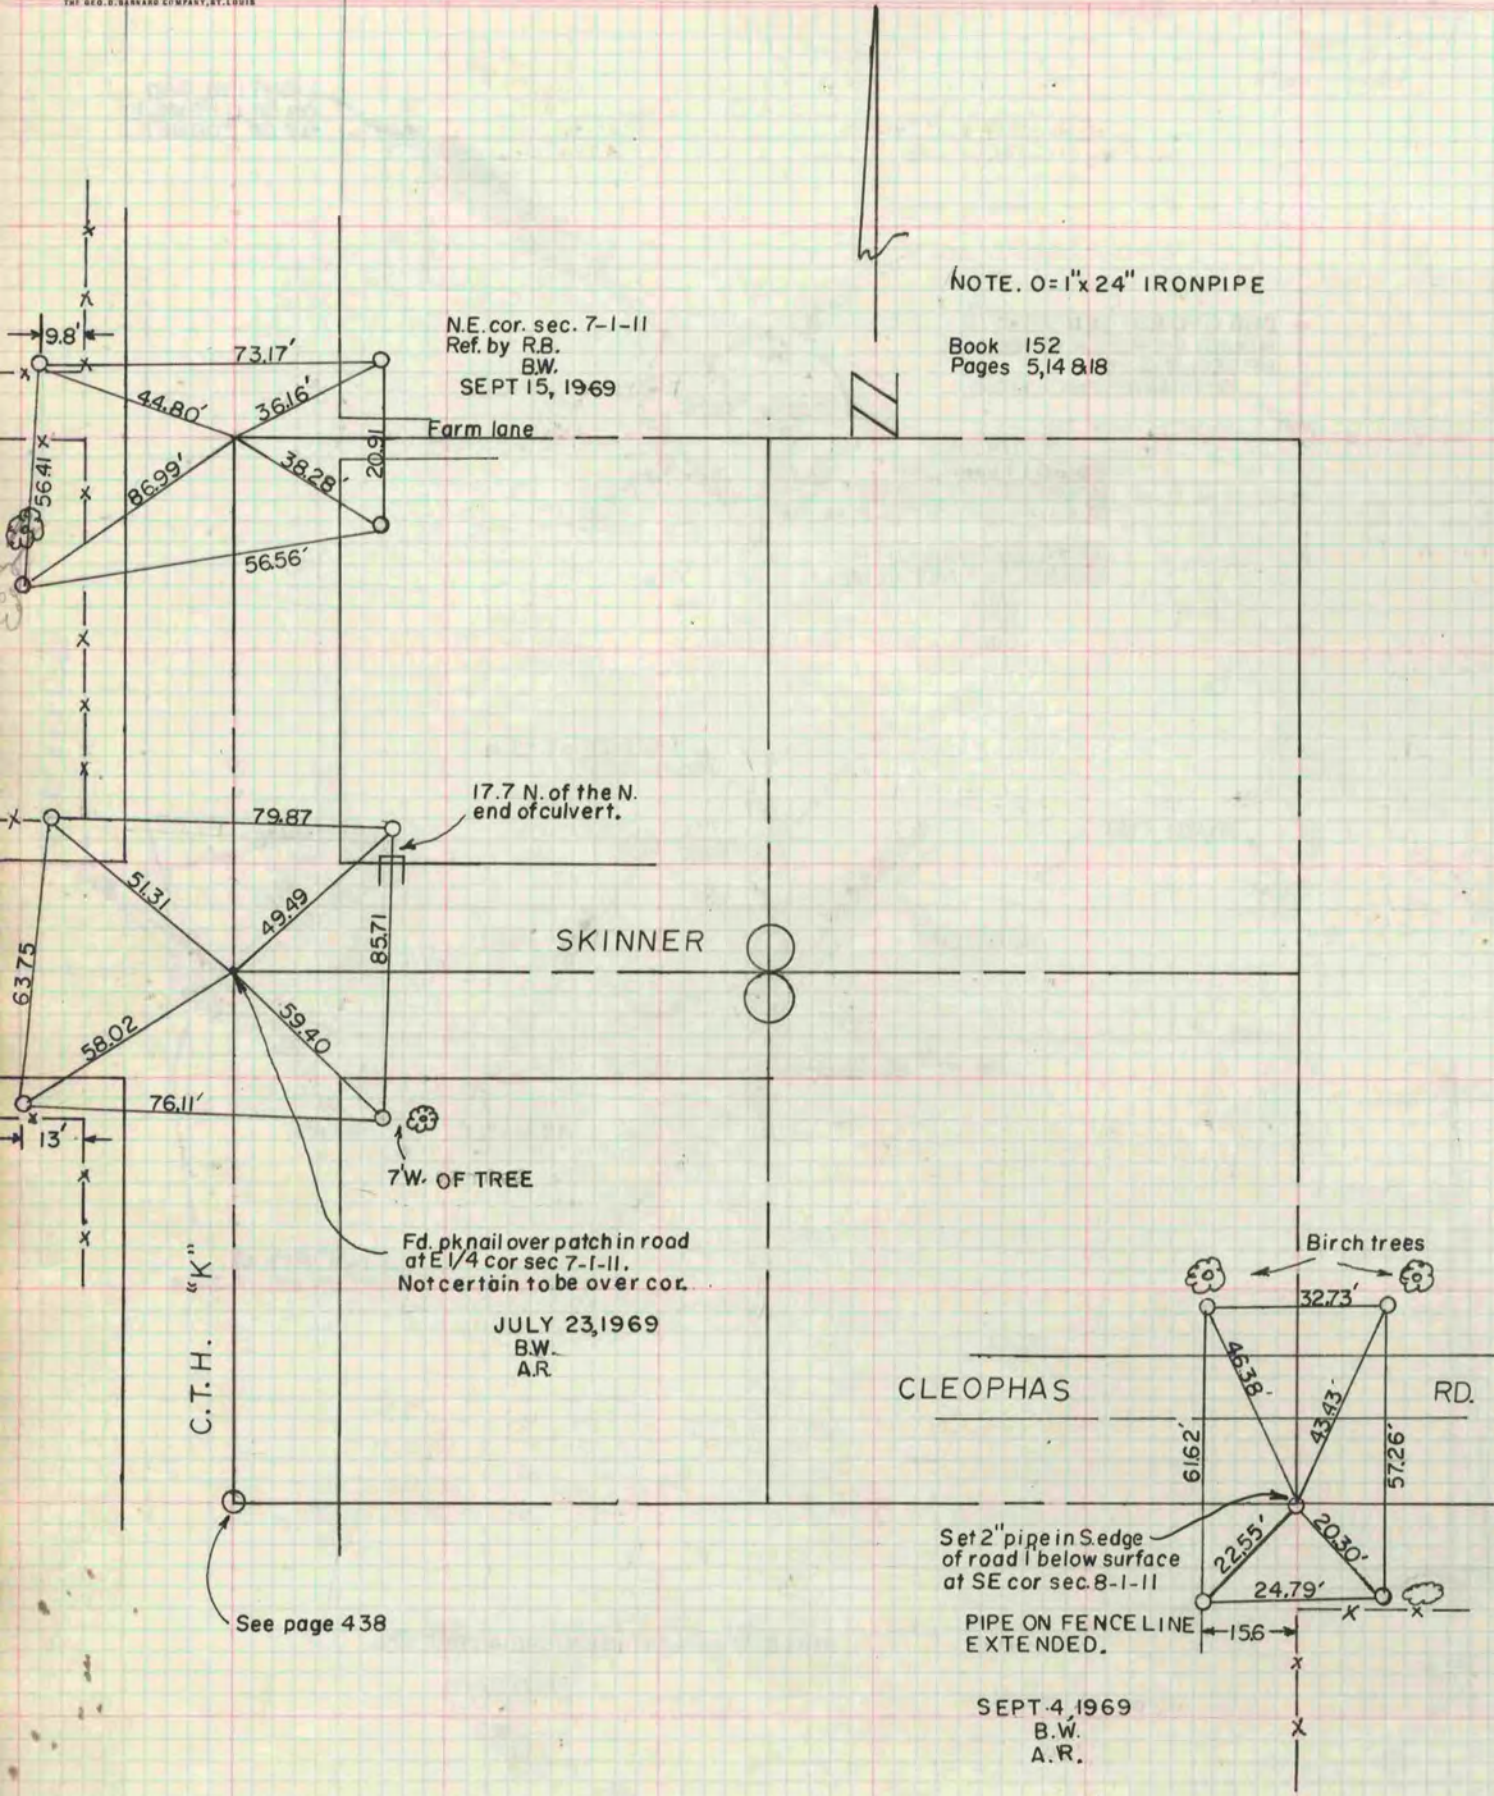

NOTE. 0=1"x24" IRON PIPE

Book 152
Pages 5,14 & 18