

# PLAT AND RECORD

r-4/ 177  
J

COUNTY BUILDING 5 773400  
CITY OF JANESVILLE 70 7715

Of a Survey on Section 4 T 1 R 12 E. of the 4 P. M. in BELOIT Township

Rock County, Wisconsin, made NOV. the 1962

I hereby certify that the following is a correct record of said survey as made by me.

**MICROFILMED**

*R. H. B. at the time*


County Surveyor.

DUG AT THE  
CENTER OF SEC.  
4-1-12 & FOUND  
NOTHING.

ROAD

DUG AT THE S.E. COR. OF THE S.W. 1/4  
OF THE NW. 1/4 OF SEC. 4-1-12 & FOUND  
NOTHING.

POLE NO.  
W.P. & L. "J"  
1-12-4  
0/25

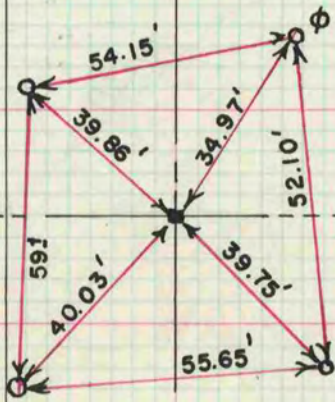

DUG AT THE WEST 1/4 COR. OF  
SEC. 4-1-12 AND FOUND AN OLD AXLE,  
REFERENCED AND SET A MON. BOX.

J. KANE - WORK PROJECT SUPERVISOR.

FINLEY