

# PLAT AND RECORD

449

V-4

COUNTY BUILDING  
CITY OF JANESVILLE

COUNTY BUILDING  
CITY OF JANESVILLE

Of a Survey on Section 24 T 4N. R 10 E. of the 4 P. M. in UNION Township

Rock County, Wisconsin, made SEPT. the 24 1970


I hereby certify that the following is a correct record of said survey as made by me.

COUNTY BUILDING  
CITY OF JANESVILLE

MICROFILMED

*R.B. Bottorff*

County Surveyor.

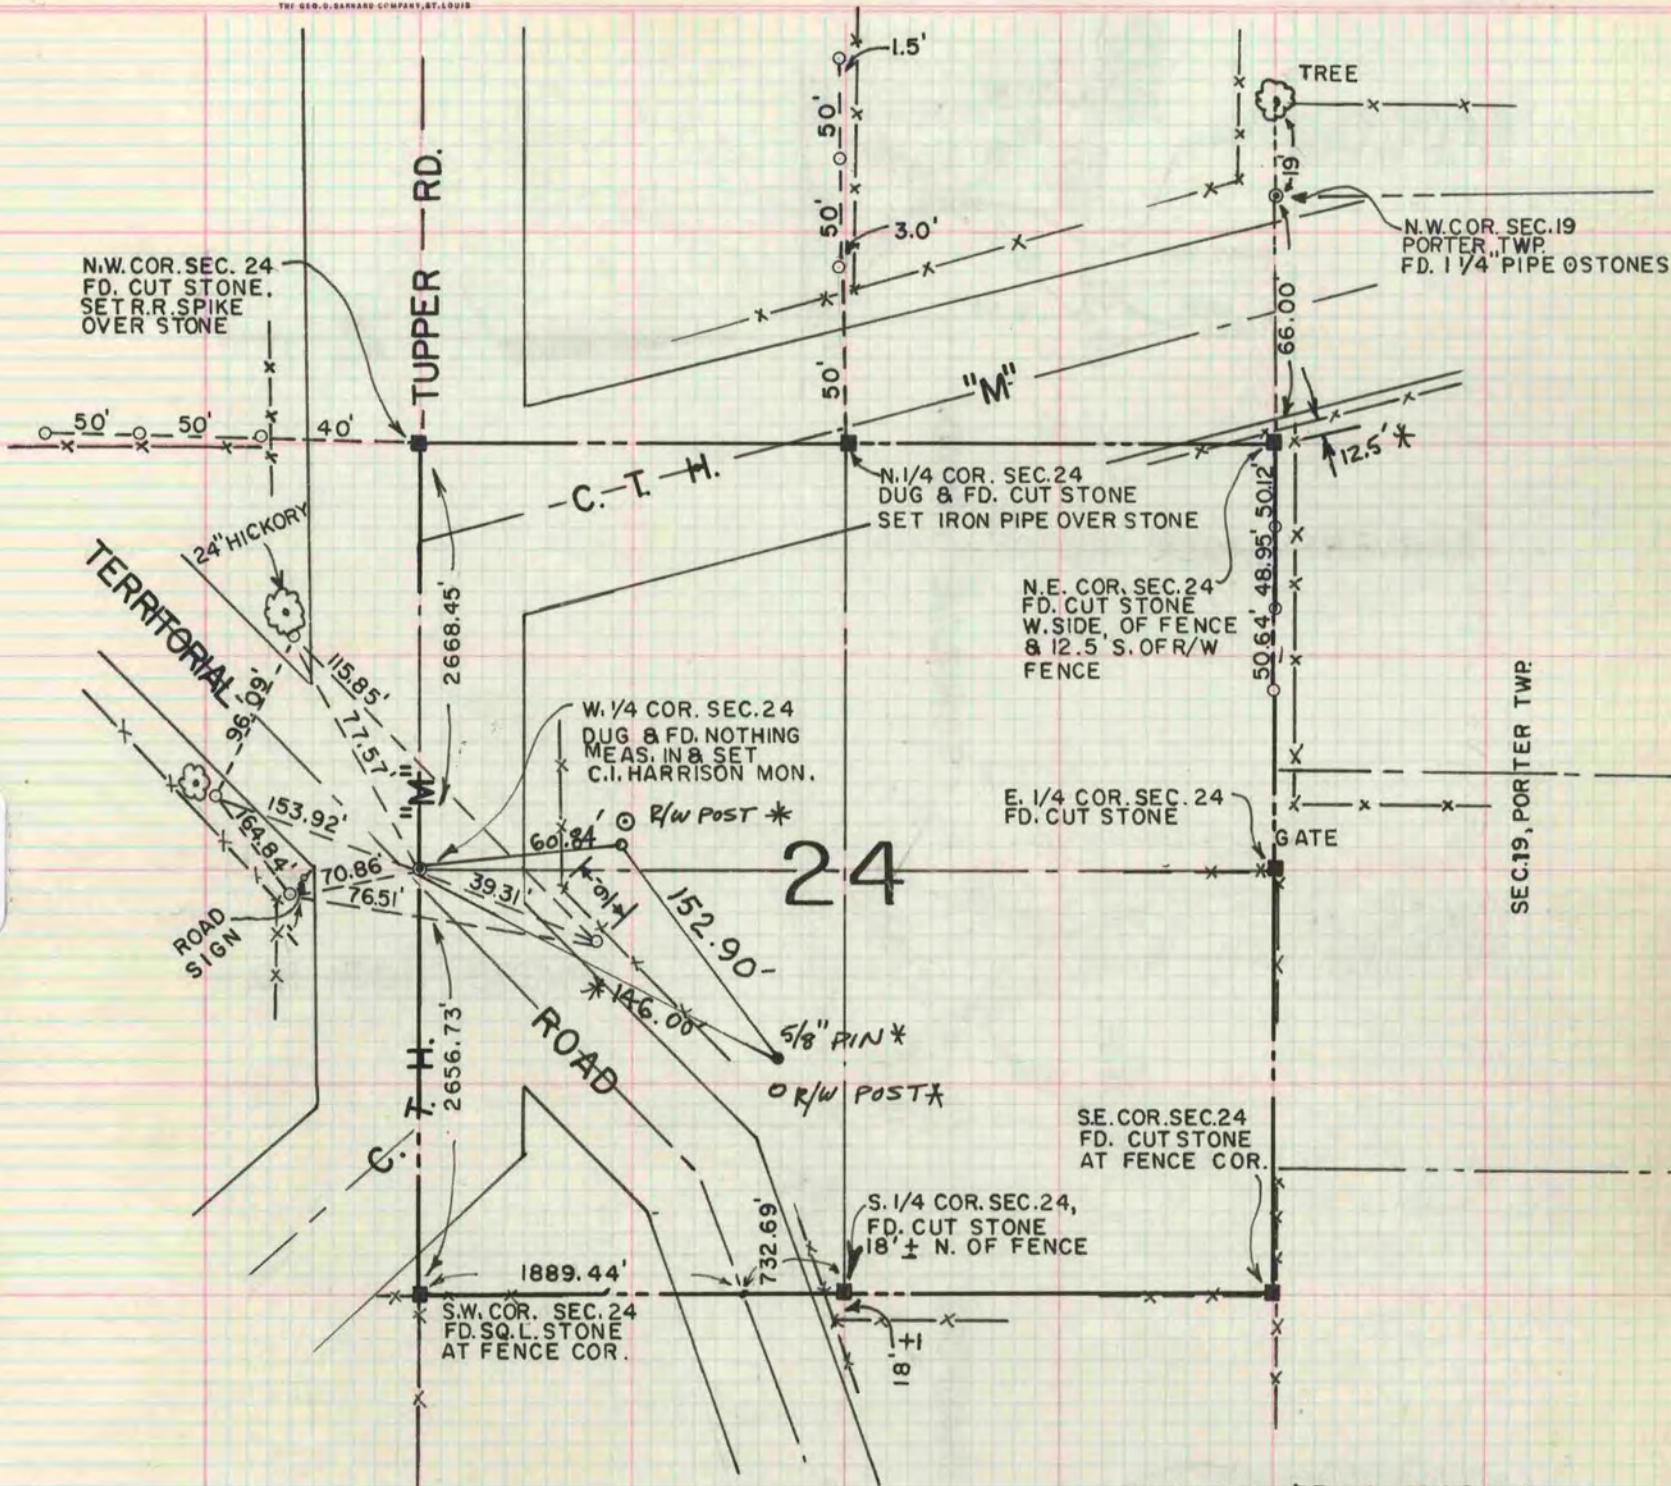

\* COPIED FROM BELOIT REC  
12/11/75 DAB.



NOTE: ○ = 1" x 24" IRON PIPES

SEPT. 24, 1970  
H.J.L.  
J.M.S.  
R.B.  
R.T.  
G.B.