

PLAT AND RECORD



559

VOL. 5

Of a Survey on Section **7,8** T **3** R **11** E. of the 4 P. M. in **CENTER** Township
 Rock County, Wisconsin, made **AUG** the **28** 19**29**

I hereby certify that the following is a correct record of said survey as made by me.

COUNTY BUILDING
CITY OF JANESVILLE

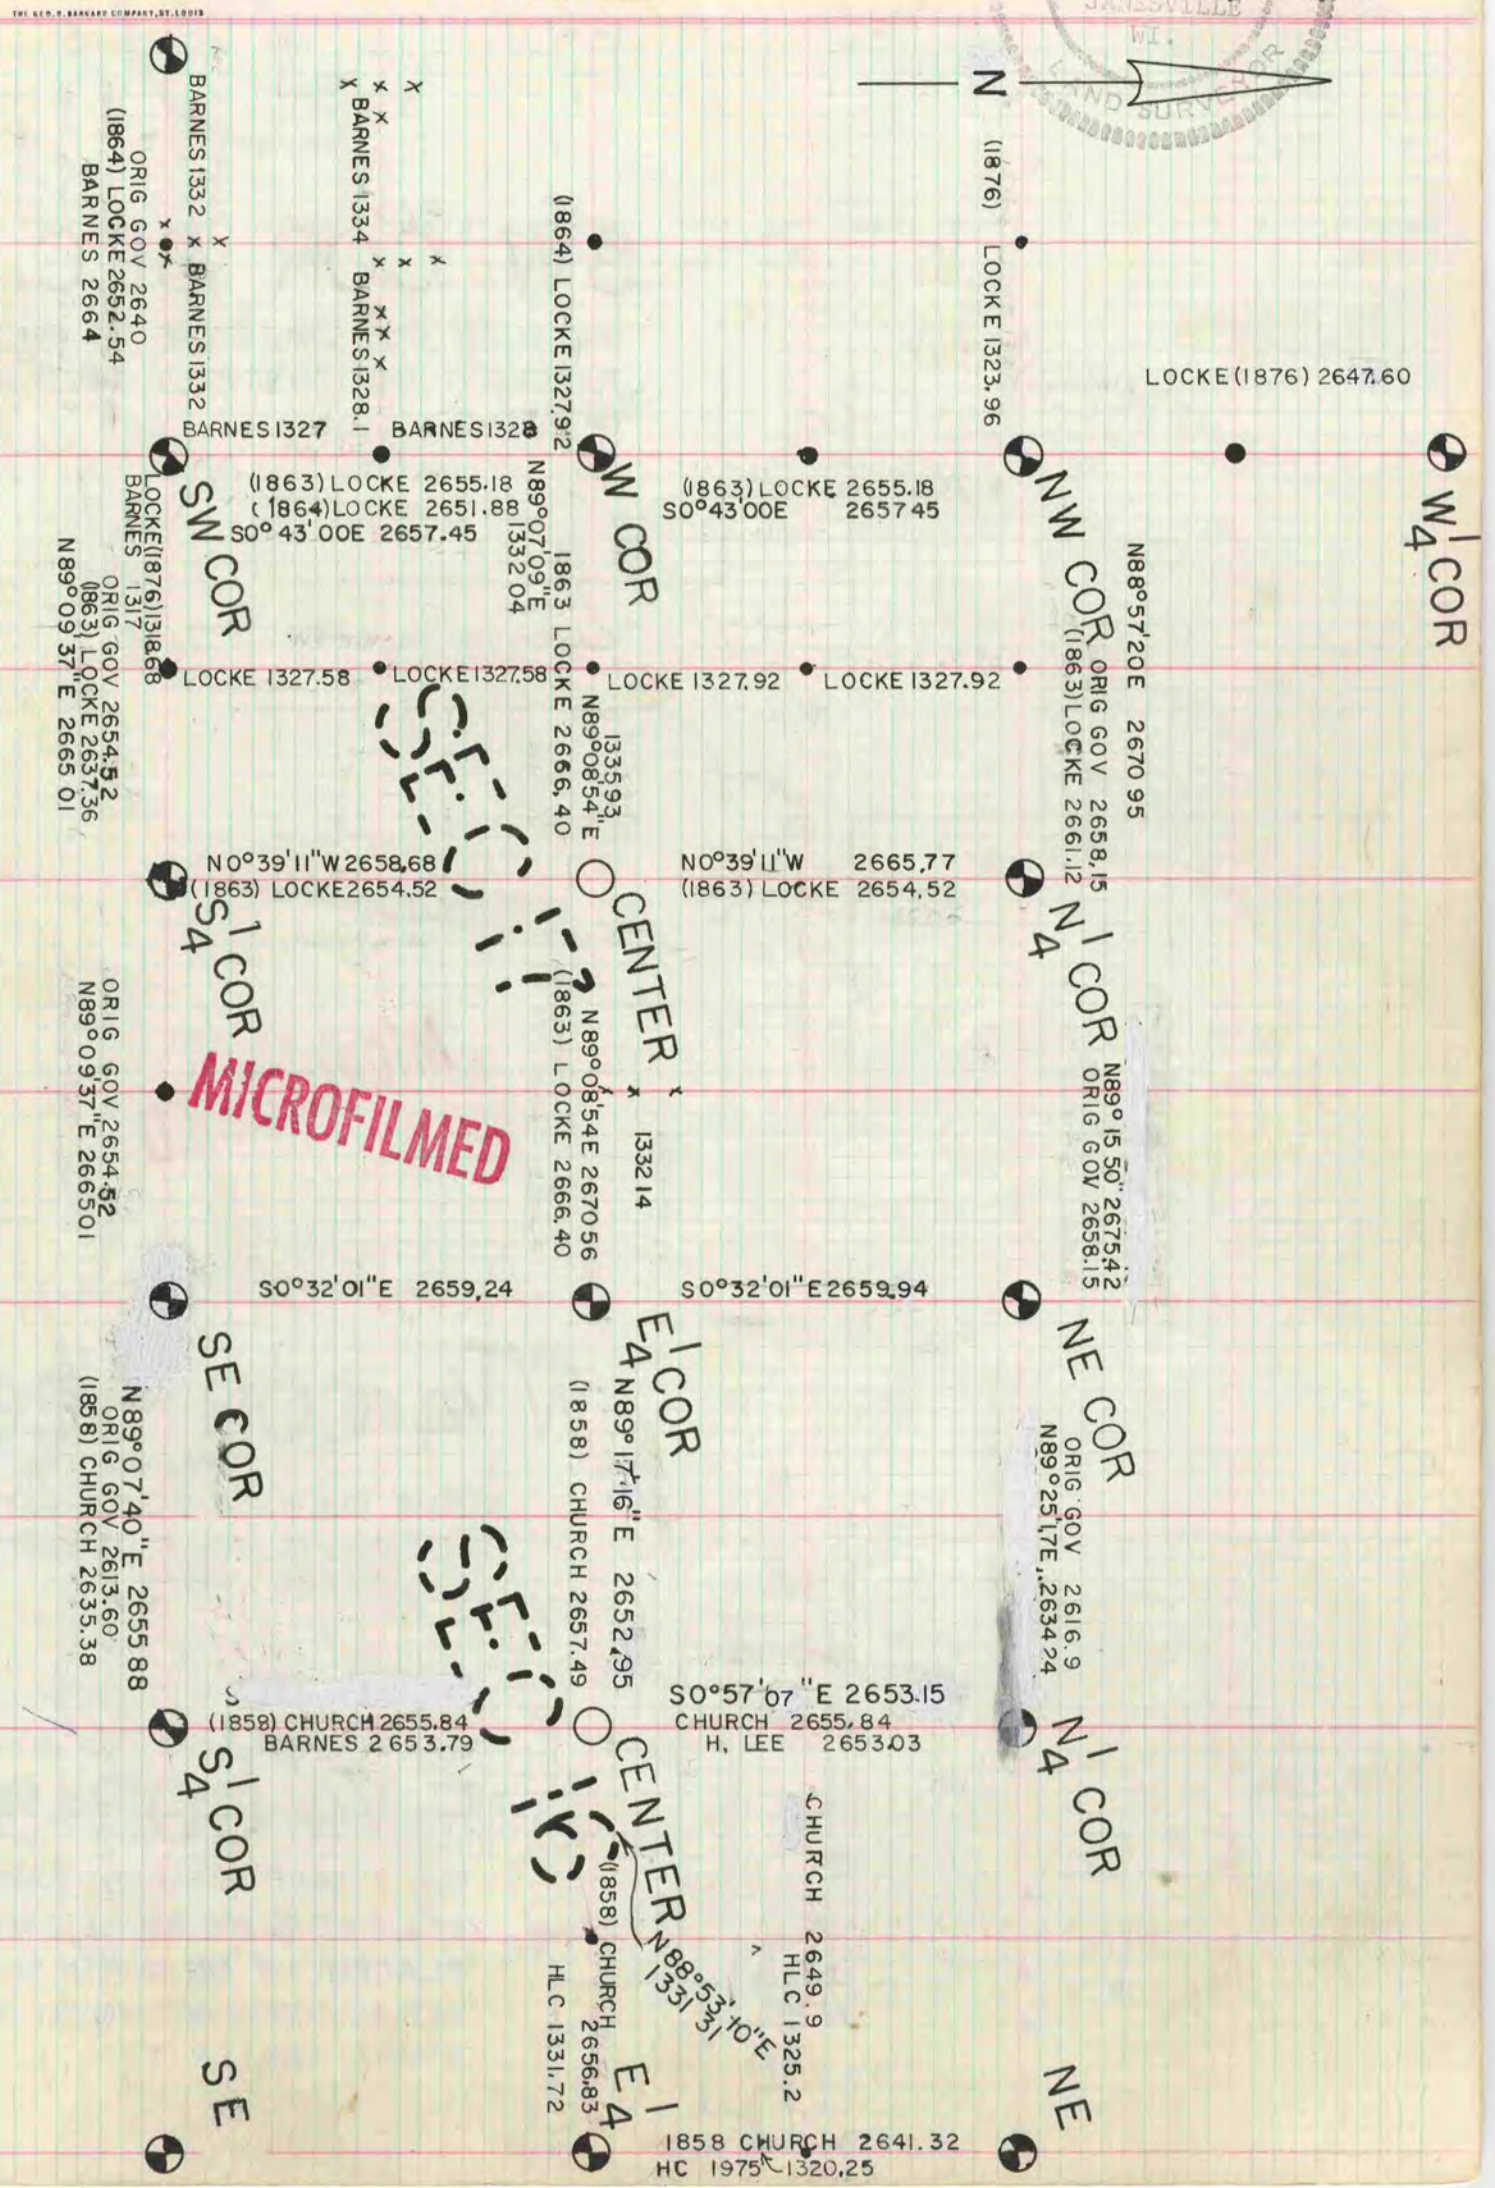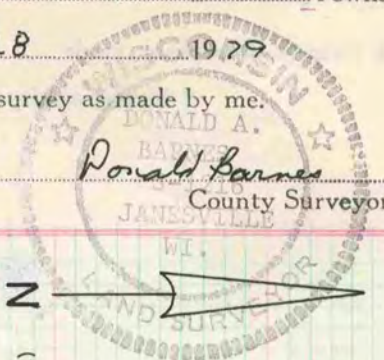

MICROFILMED

SECTION 7

SECTION 8