

# PLAT AND RECORD

557



VOL. 5

Of a Survey on Section 22 T 1 R 10 E. of the 4 P. M. in AVON Township  
Rock County, Wisconsin, made JULY the 31 19 79

I hereby certify that the following is a correct record of said survey as made by me.

COUNTY BUILDING  
CITY OF JANESVILLE

*Donald Barnes*

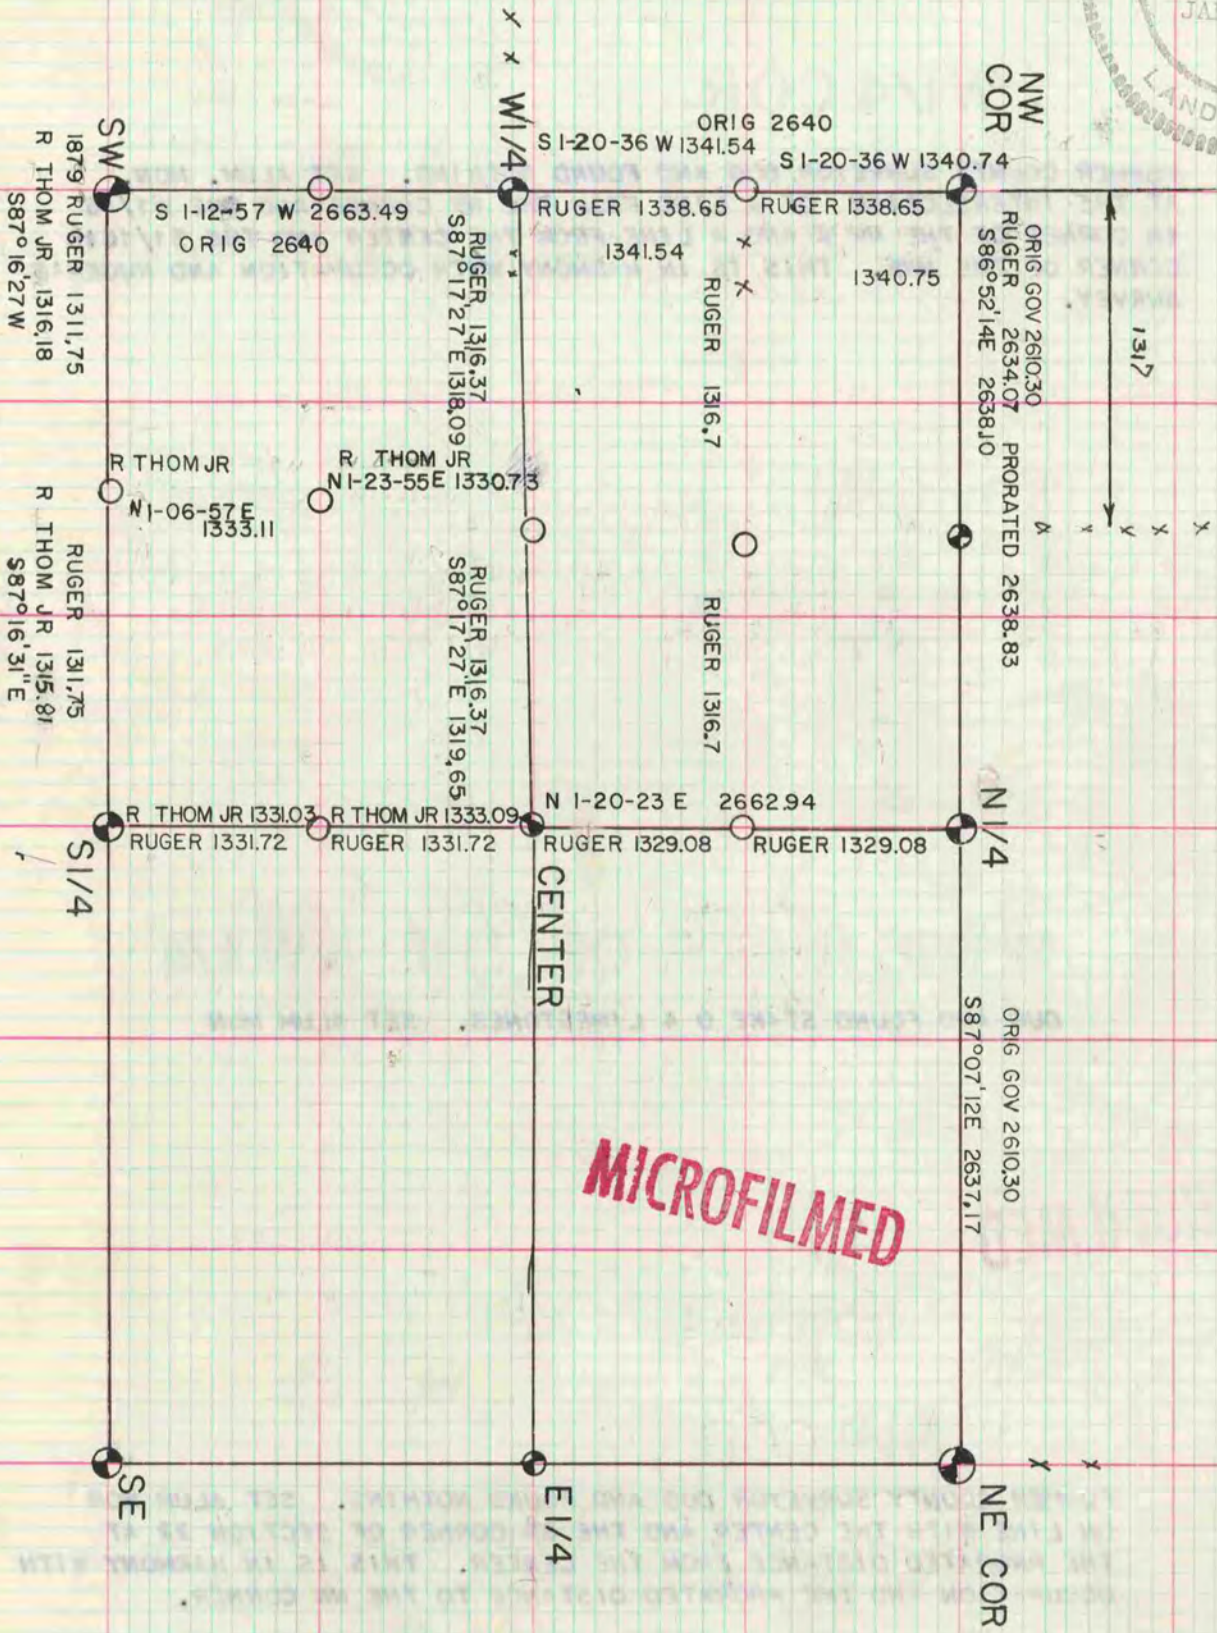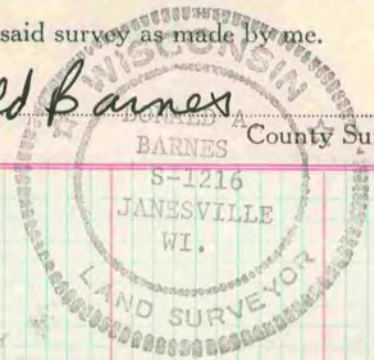

**MICROFILMED**

560-2-2