

# PLAT AND RECORD

547  
V-4

CITY OF JANESVILLE  
COUNTY BUILDING

COUNTY BUILDING  
CITY OF JANESVILLE

Of a Survey on Section **36** T **3N**, R **13** E. of the 4 P. M. in **HARMONY** Township


Rock County, Wisconsin, made **MAY** the **28th** 19**71**

I hereby certify that the following is a correct record of said survey as made by me.

*Hugh Lee*

County Surveyor.

**MICROFILMED**

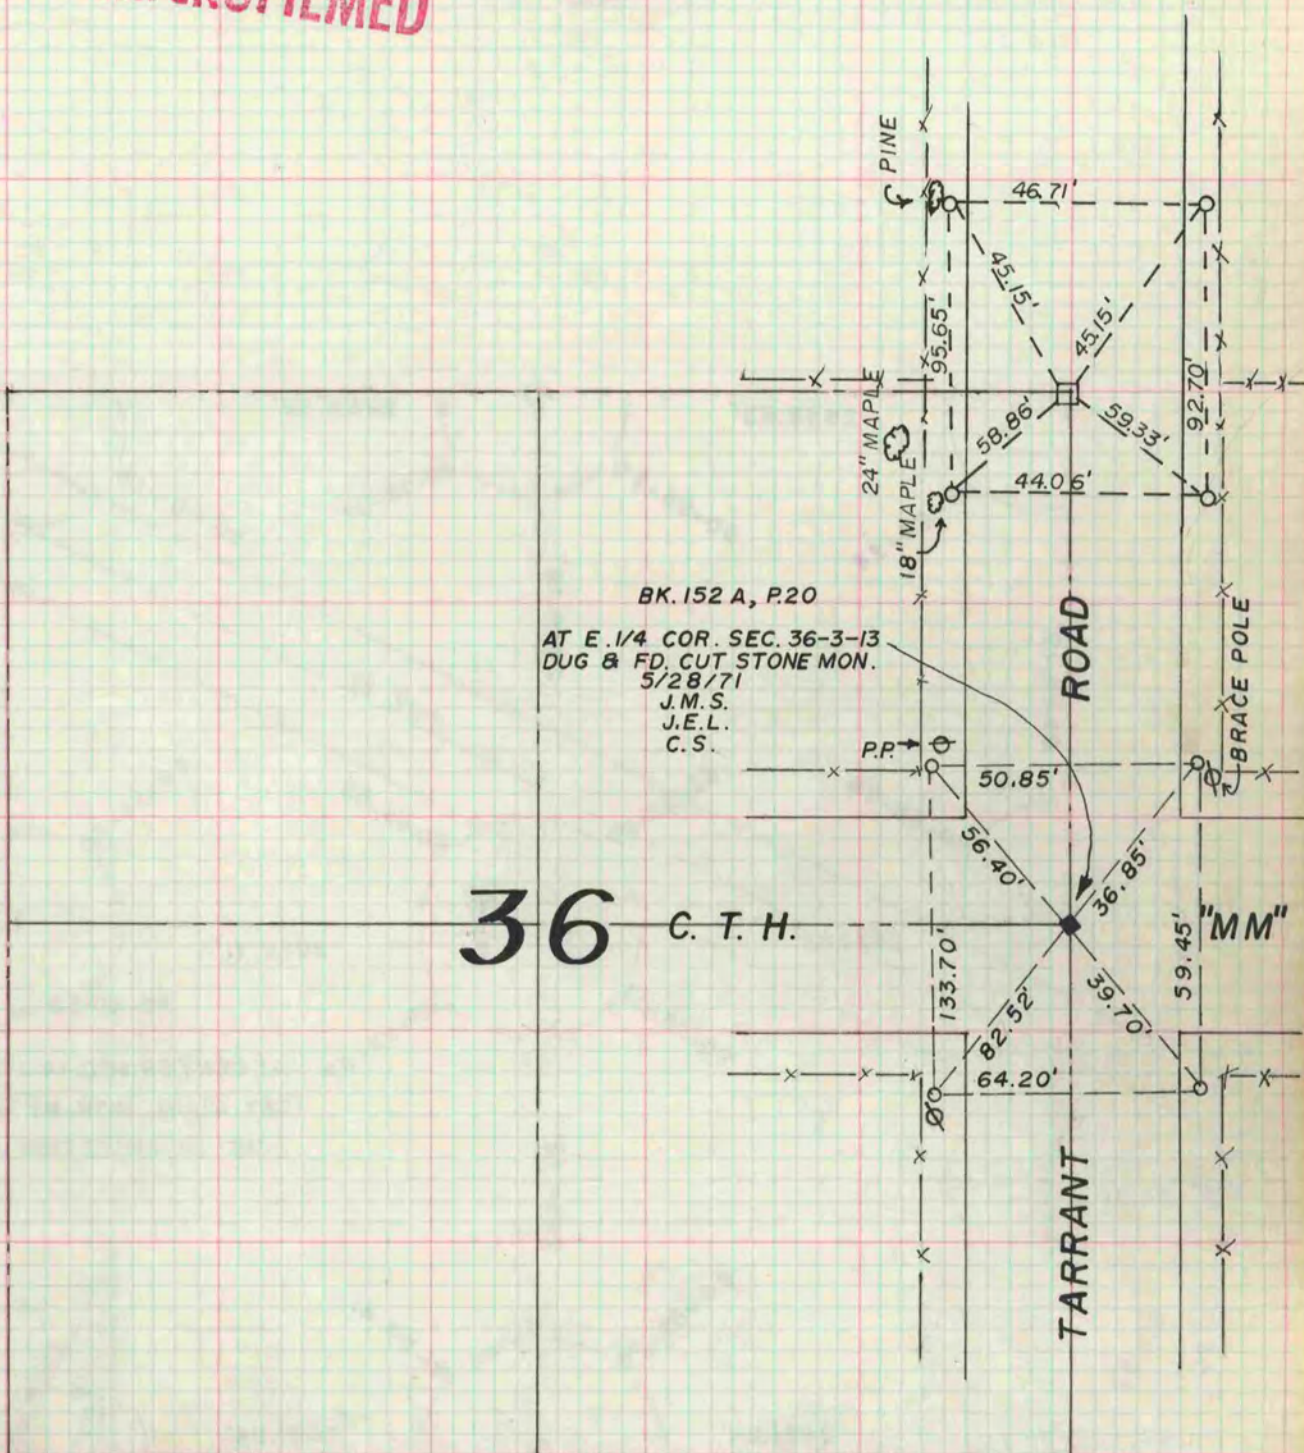

NOTE: O=1"x24" IRON PIPE REF. MON.

