

1-2 MICROFILMED

# PLAT AND RECORD


Of a Survey on Section  $W\frac{1}{2}, S.E\frac{1}{4}$  14 T 2 R 11 E. of the 4 P. M. in Plymouth Township  
Rock County, Wisconsin, made May the 20 1874

I hereby certify that the following is a correct record of said survey as made by me.

COUNTY BUILDING  
CITY OF JANESVILLE

(Signed) Edward Ruger  
R.H.B.

County Surveyor.

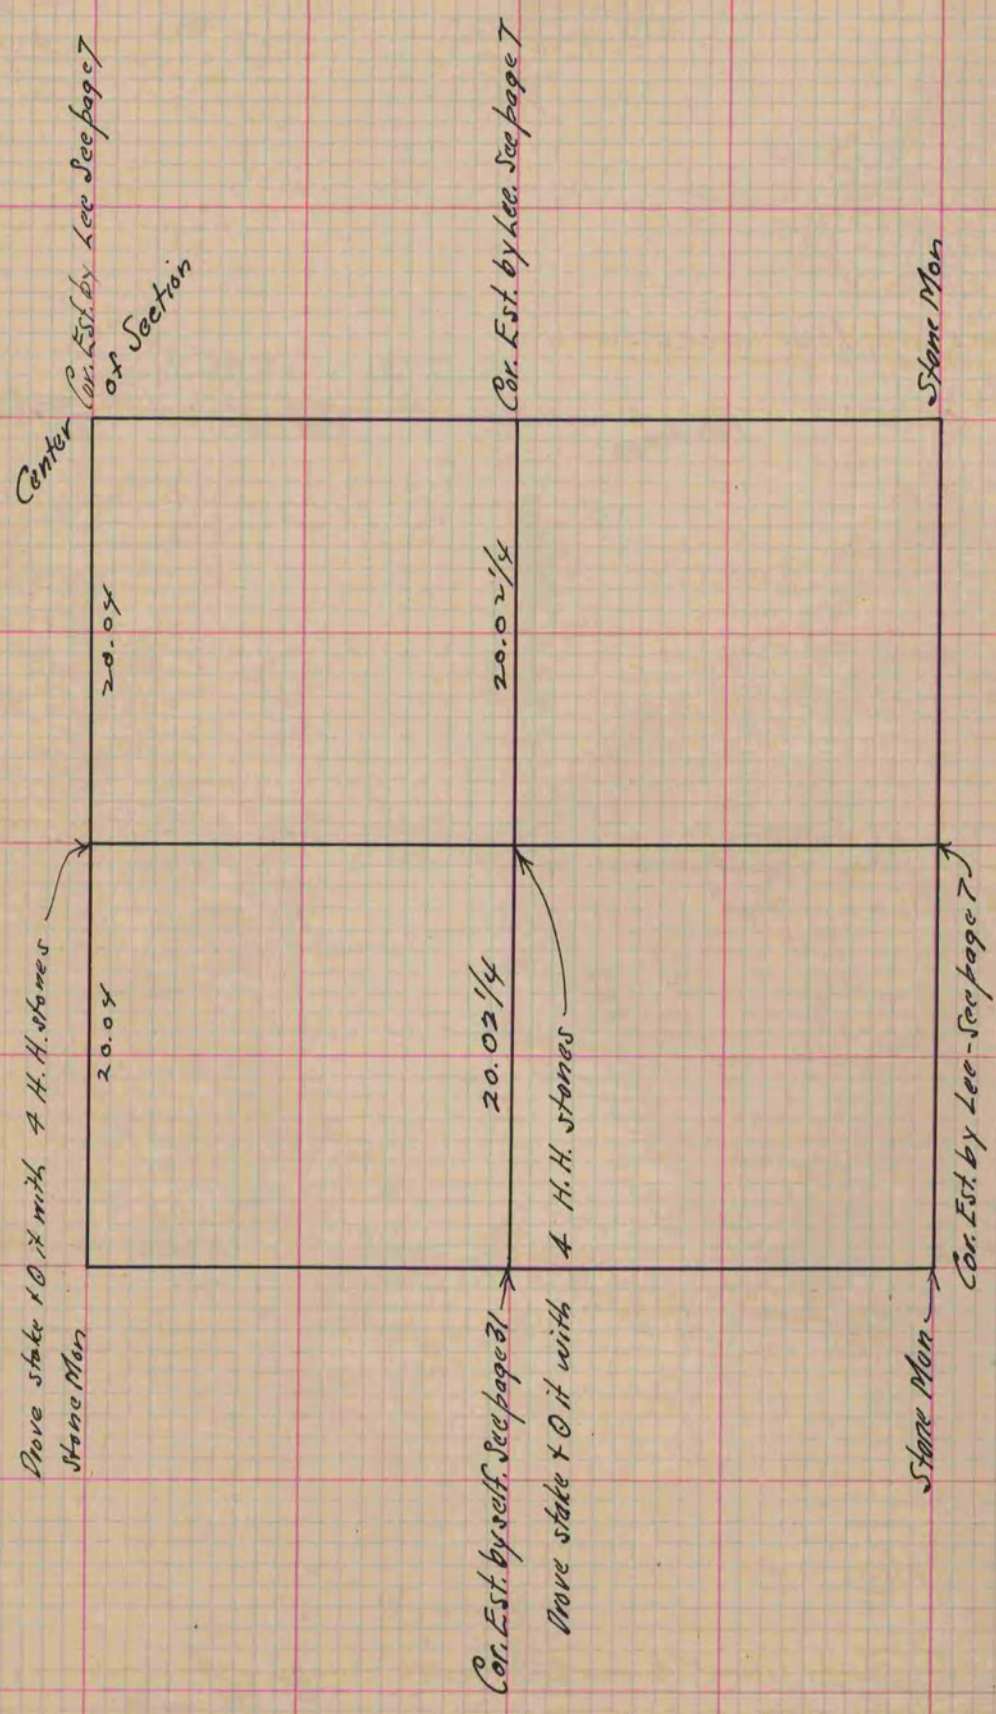

Copied from P. 95 V. 2. Original County Surveyors Record.