

PLAT AND RECORD

COUNTY BUILDING
CITY OF JANESVILLE

Of a Survey on Section 31 T 3N R 12 E. of the 4 P. M. in JANESVILLE Township



Rock County, Wisconsin, made MARCH the 11 1970

I hereby certify that the following is a correct record of said survey as made by me.

MICROFILMED

R.M. Batteman

County Surveyor.

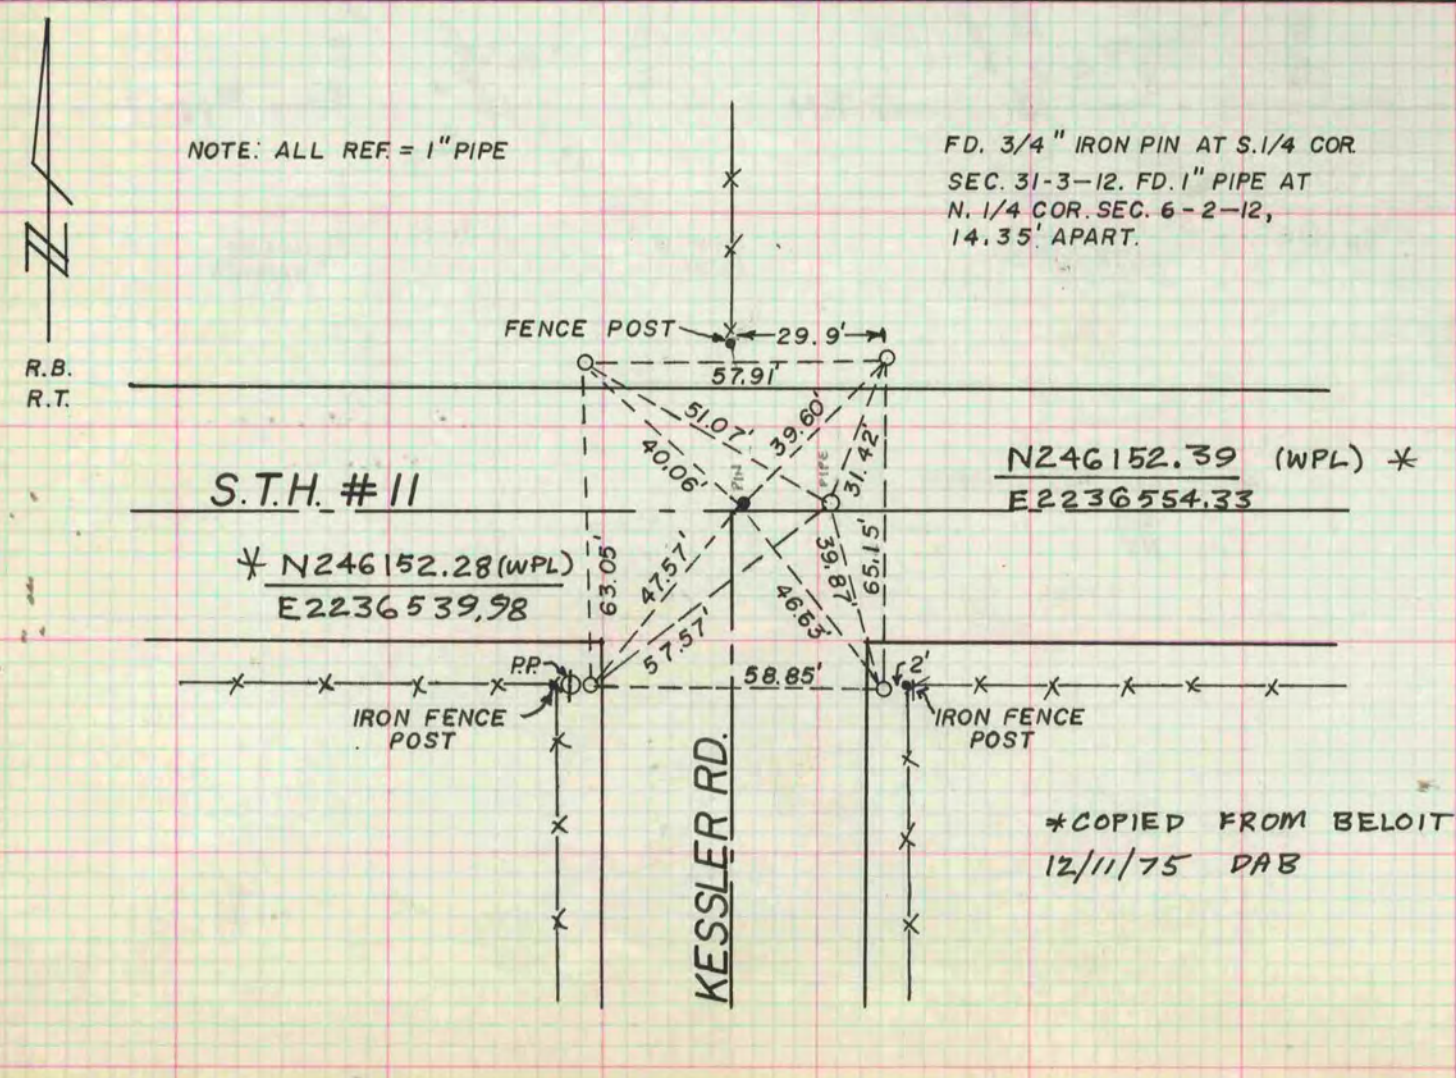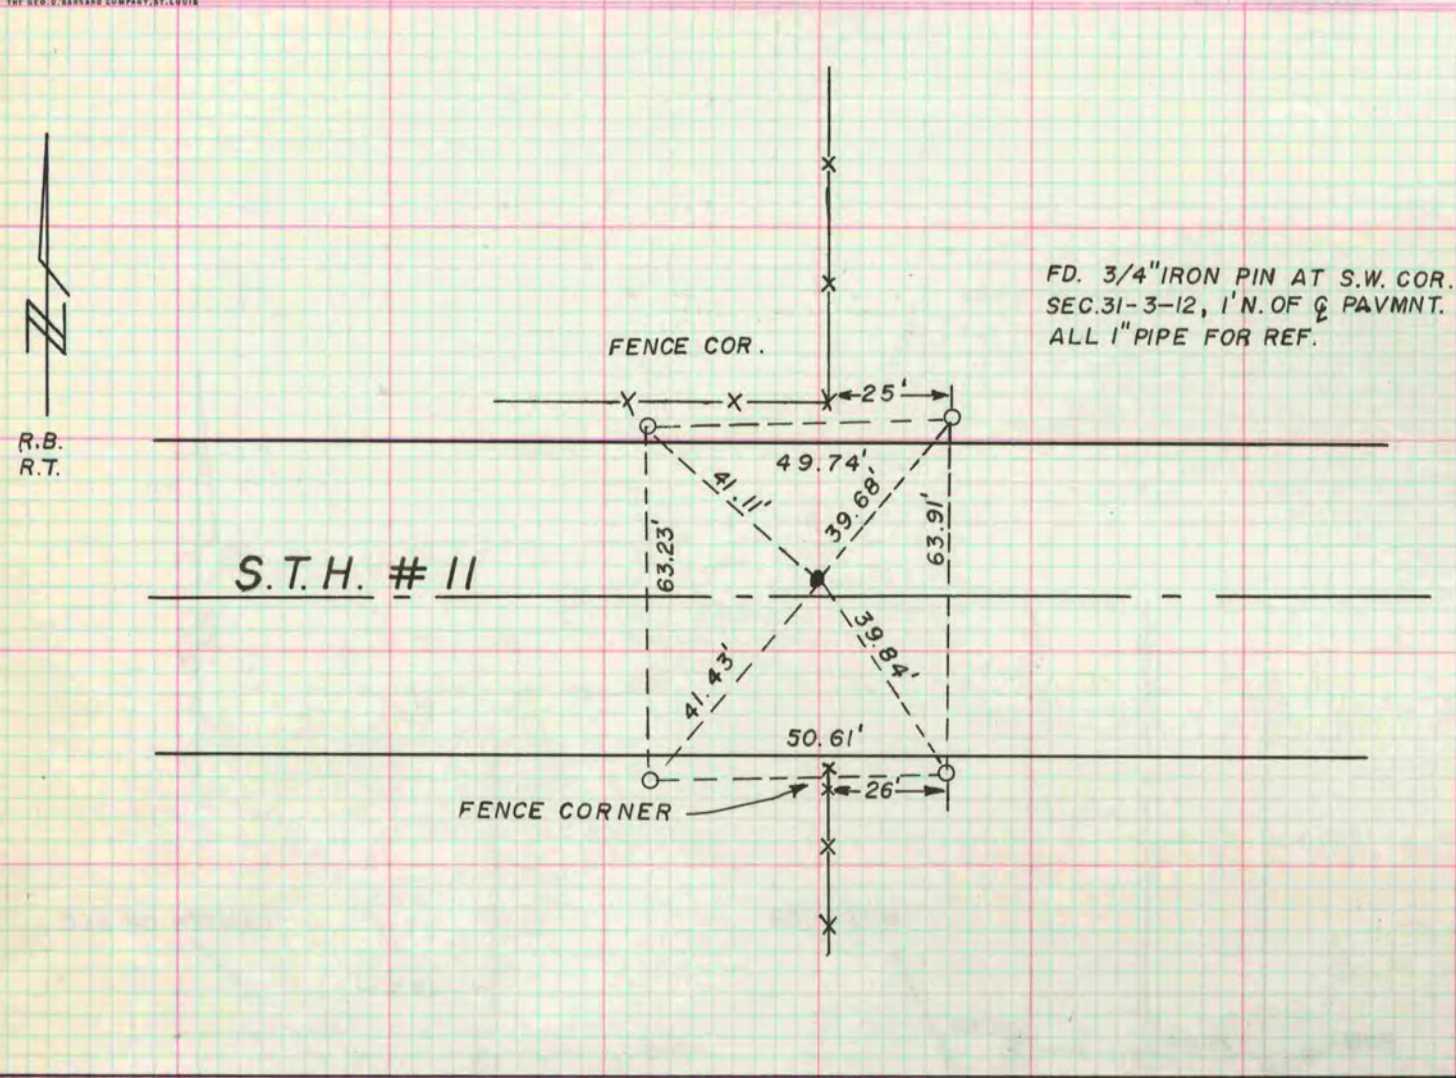

*COPIED FROM BELOIT REC
12/11/75 DAB