

PLAT AND RECORD

523
VOL. 5

Of a Survey on Section 28 T 4 R 10 E. of the 4 P. M. in UNION Township

Rock County, Wisconsin, made MARCH the 27 19 79

I hereby certify that the following is a correct record of said survey ~~as made by me.~~

COUNTY BUILDING
CITY OF JANESVILLE


COUNTY BUILDING
CITY OF JANESVILLE

County Surveyor.

NW CORNER SEC 28 FOUND STONE
W 1/4 CORNER SEC 28 FOUND STONE
E 1/4 CORNER SEC 28 FOUND ALUM MON
S 1/4 CORNER SEC 28 FOUND BROKEN STONE
S 1/16th CORNER OF THE NE 1/4 OF SEC 28 FOUND PIPE

NE 1/4 CORNER OF SEC 28

MICROFILMED

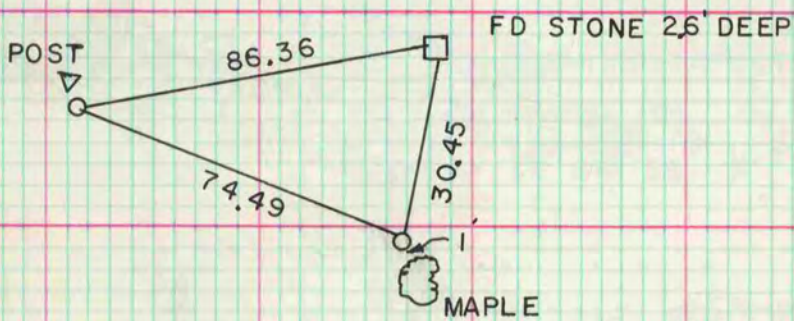

INFORMATION SUPPLIED BY W KIENBAUM