

# PLAT AND RECORD

203

VOL. 6

Of a Survey on Section **18** T **4** R **13** E. of the 4 P. M. in **MILTON** Township  
Rock County, Wisconsin, made **AUG.** the


I hereby certify that the following is a correct record of said survey as made by me

COUNTY BUILDING  
CITY OF JANESVILLE

Donald Barnes  
S-1216  
JANESVILLE  
WI. County Surveyor.



**SE COR SEC 18**  
FOUND 5/8" RE-BAR REPLACED WITH ALUM MON

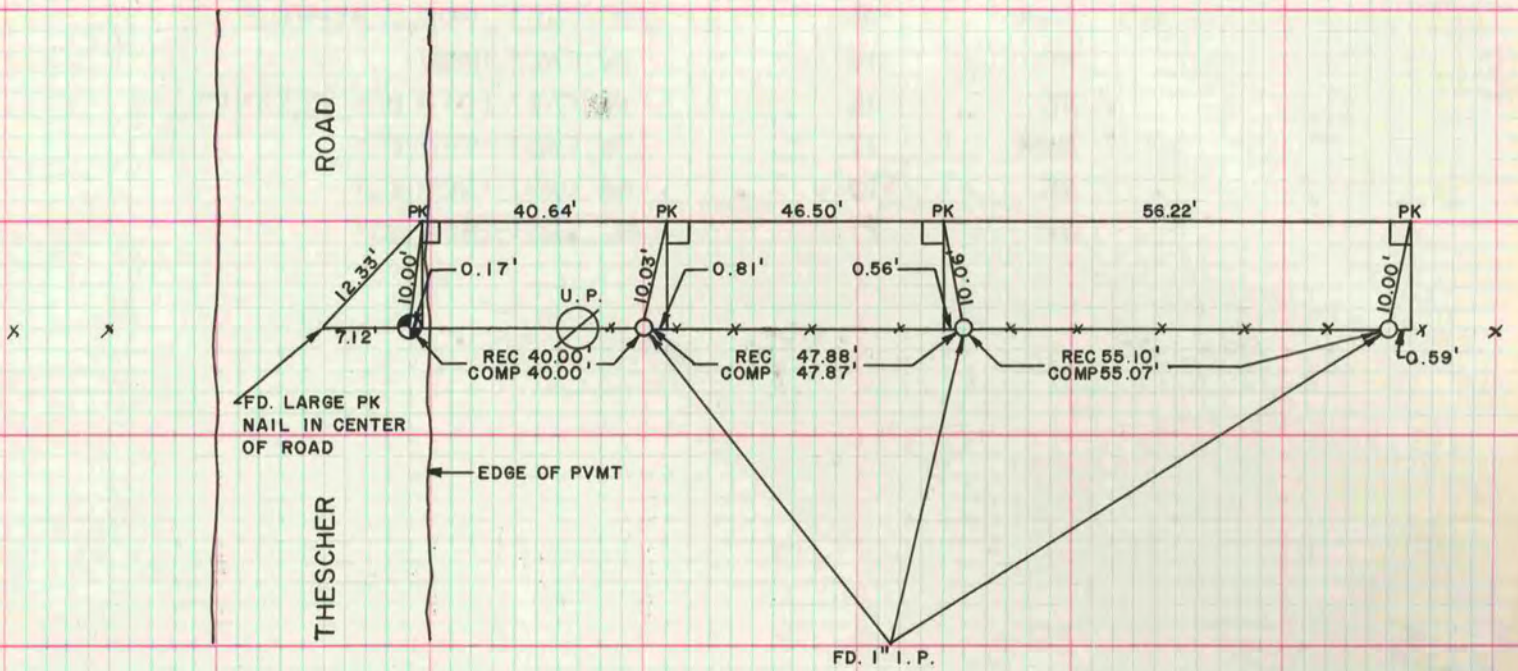

NOTE - FARMER STOPPED BY AND SAID THE FENCE IS GOING TO BE RIPPED OUT IN 2 WKS. TREES & BRUSH HAD BEEN CUT & LEFT IN OUR WAY

**NE COR SEC 18**

FOUND CAST IRON MON. :

**E1/4 COR SEC 18**

FOUND CAST IRON MON. REPLACED LOST CAP

MICROFILMED