

MICROFILMED

PLAT AND RECORD

361  
V-2


COUNTY BUILDING  
CITY OF JANESVILLE

Of a Survey on Section 2 T 1 R 10 E. of the 4 P. M. in Avon Township

Rock County, Wisconsin, made November the 13th 1883

I hereby certify that the following is a correct record of said survey as made by me.

(Signed) R. K. Lee  
R. H. B. Dep. County Surveyor.

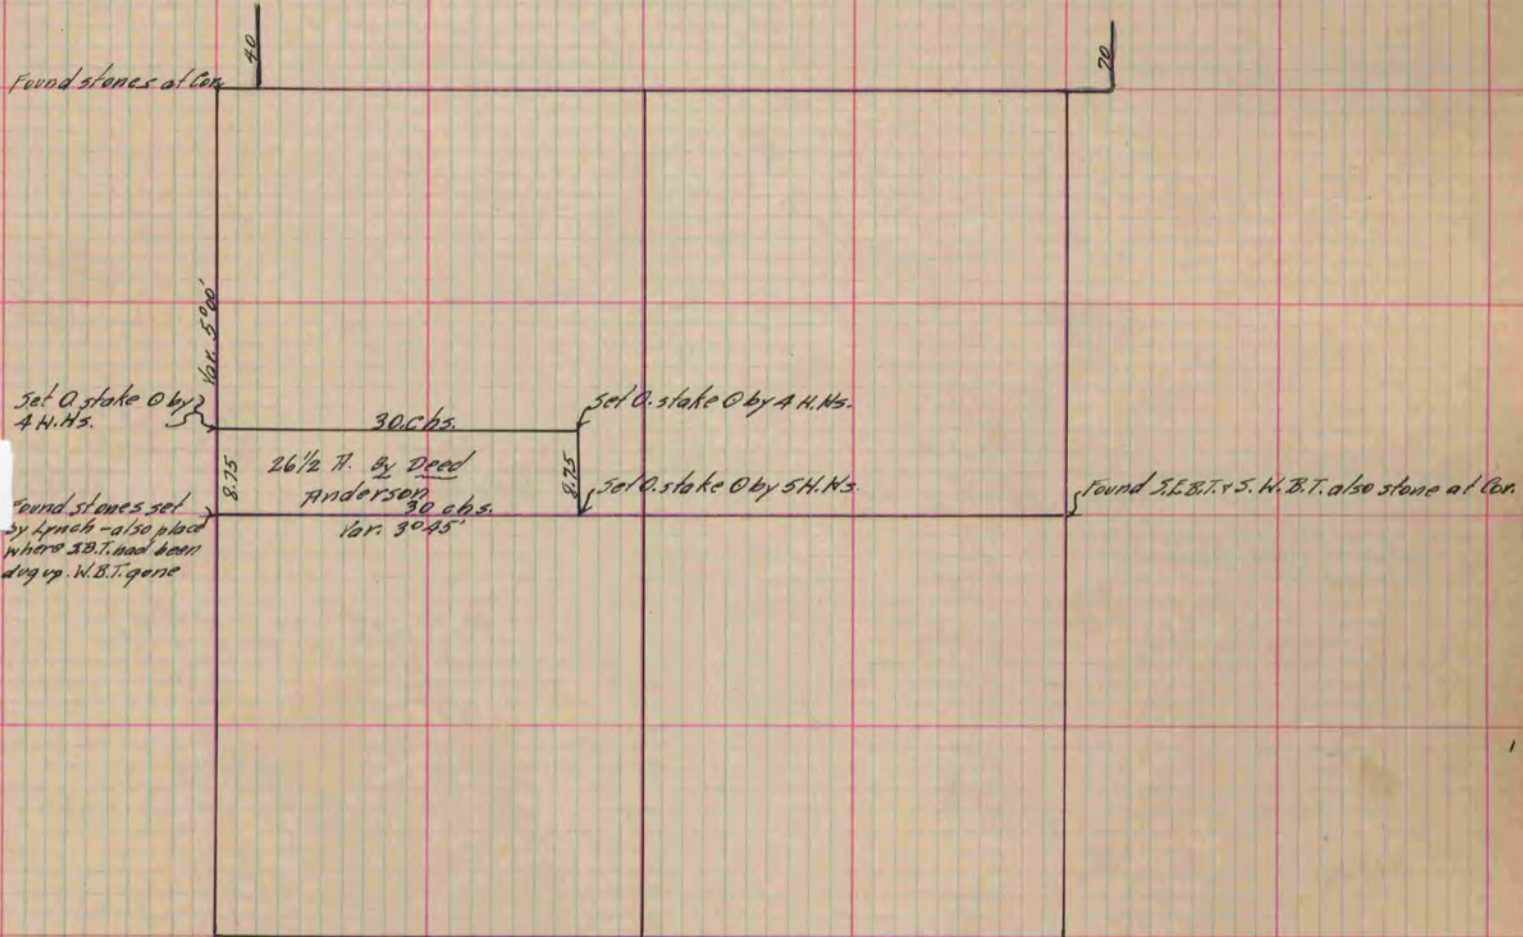

Copied from P. 291 Vol. 2 County Surveyors Record.

7