

360
V-2

MICROFILMED

PLAT AND RECORD


Of a Survey on Section 5 T 2 R 13 E. of the 4 P. M. in La Prairie Township
Rock County, Wisconsin, made _____ the _____ 19____

I hereby certify that the following is a correct record of said survey as made by me.

COUNTY BUILDING
CITY OF JANESVILLE

(Signed) Edward Ruger
R.H.B.

County Surveyor.

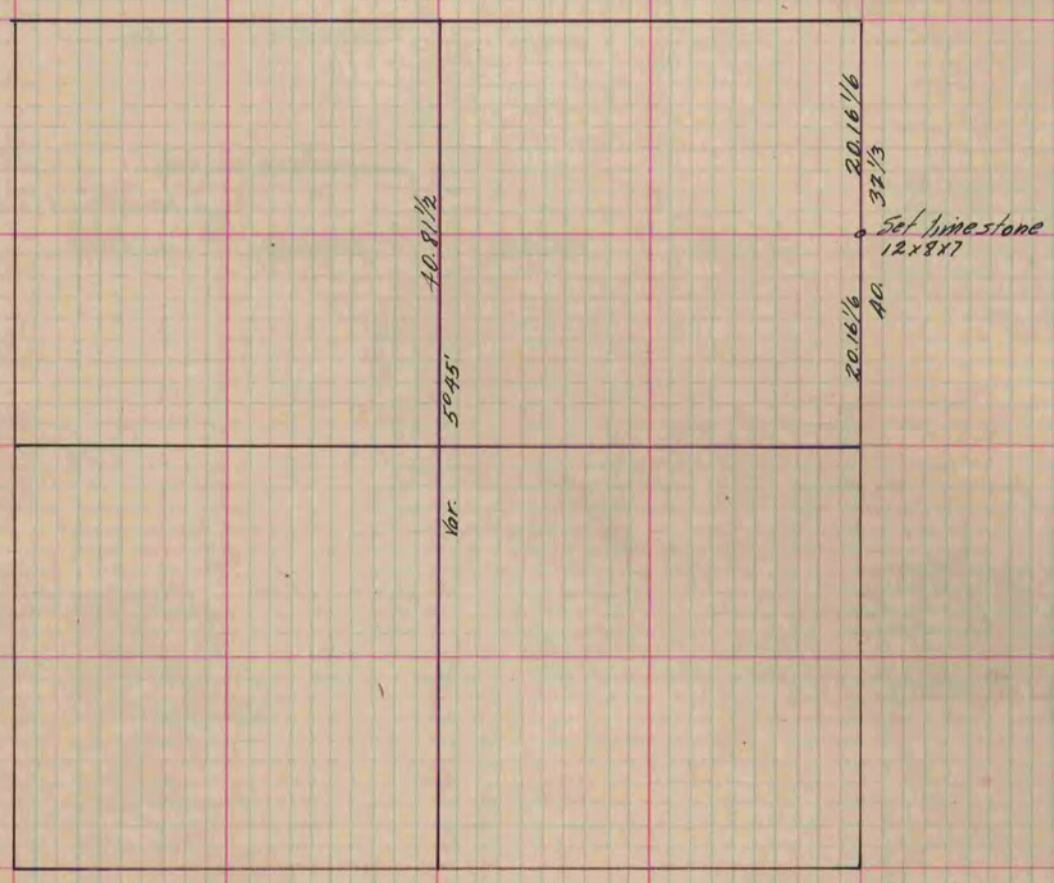

Copied from P. 290 Vol. 2 County Surveyors Record.