

V-2 MICROFILMED

# PLAT AND RECORD


Of a Survey on Section 27 T 2 R 14 E. of the 4 P. M. in Bradford Township

Rock County, Wisconsin, made December the 27<sup>th</sup> 1880

COUNTY BUILDING  
CITY OF JANESVILLE

I hereby certify that the following is a correct record of said survey as made by me.

(Signed) R. K. Lee Dept.  
R.H.B. County Surveyor.

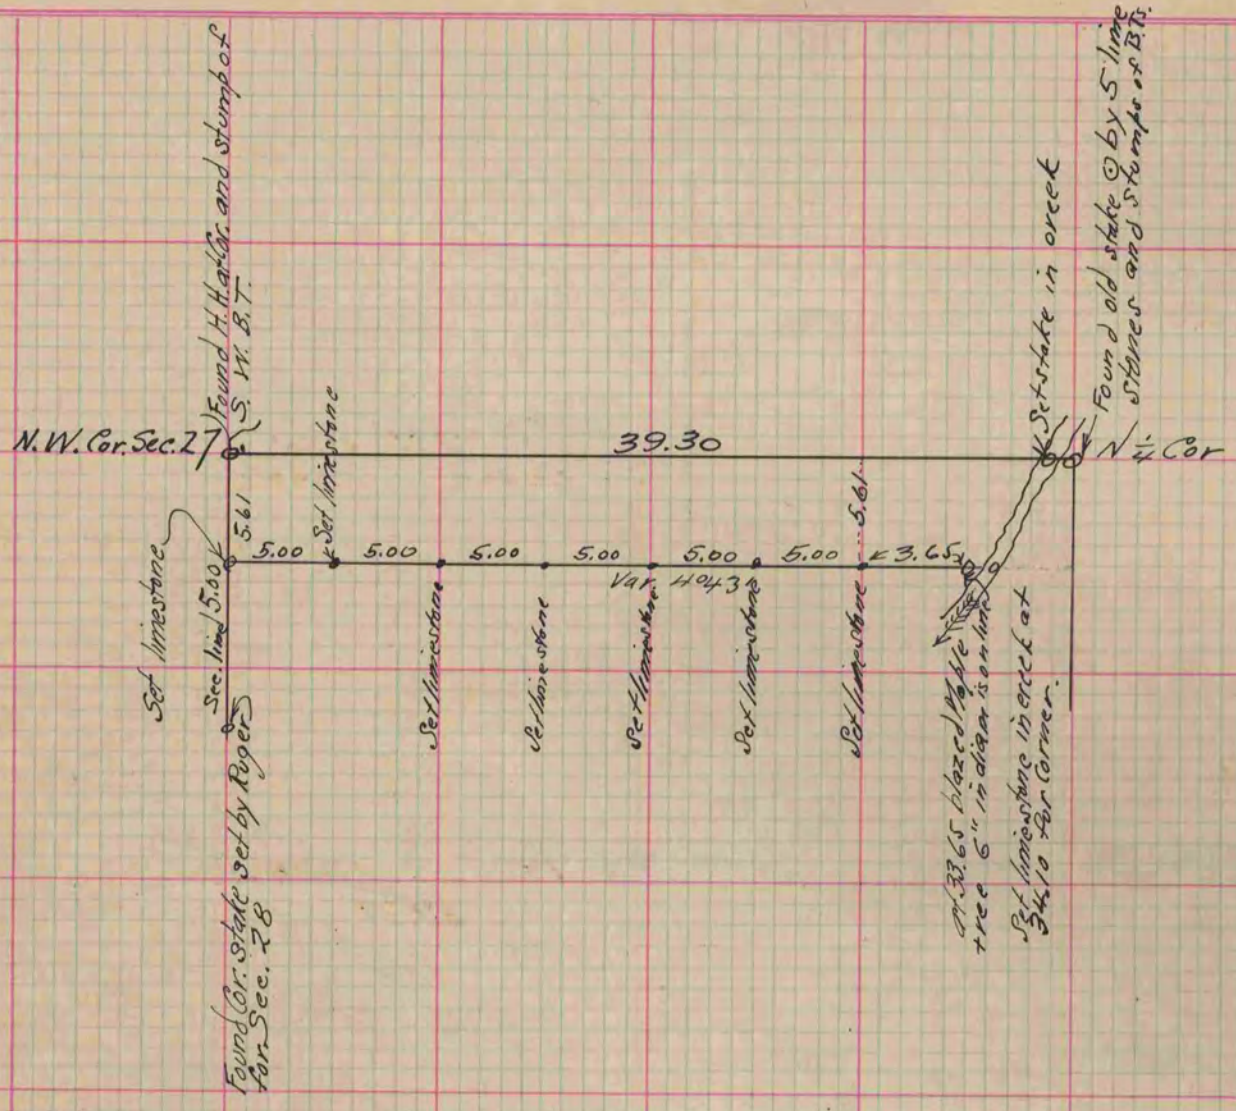

Copied from P. 262 Vol. 2. County Surveyors Record