

578
32

VOL. 6 PLAT AND RECORD

BRADFORD JOHNSTOWN


Of a Survey on Section 4 2 14 E. of the 4th M. R. 3 14 Township
Rock County, Wisconsin, made APRIL 19 80

I hereby certify that the following is a correct record of said survey as made by me.

COUNTY BUILDING
CITY OF JANESVILLE



County Surveyor.

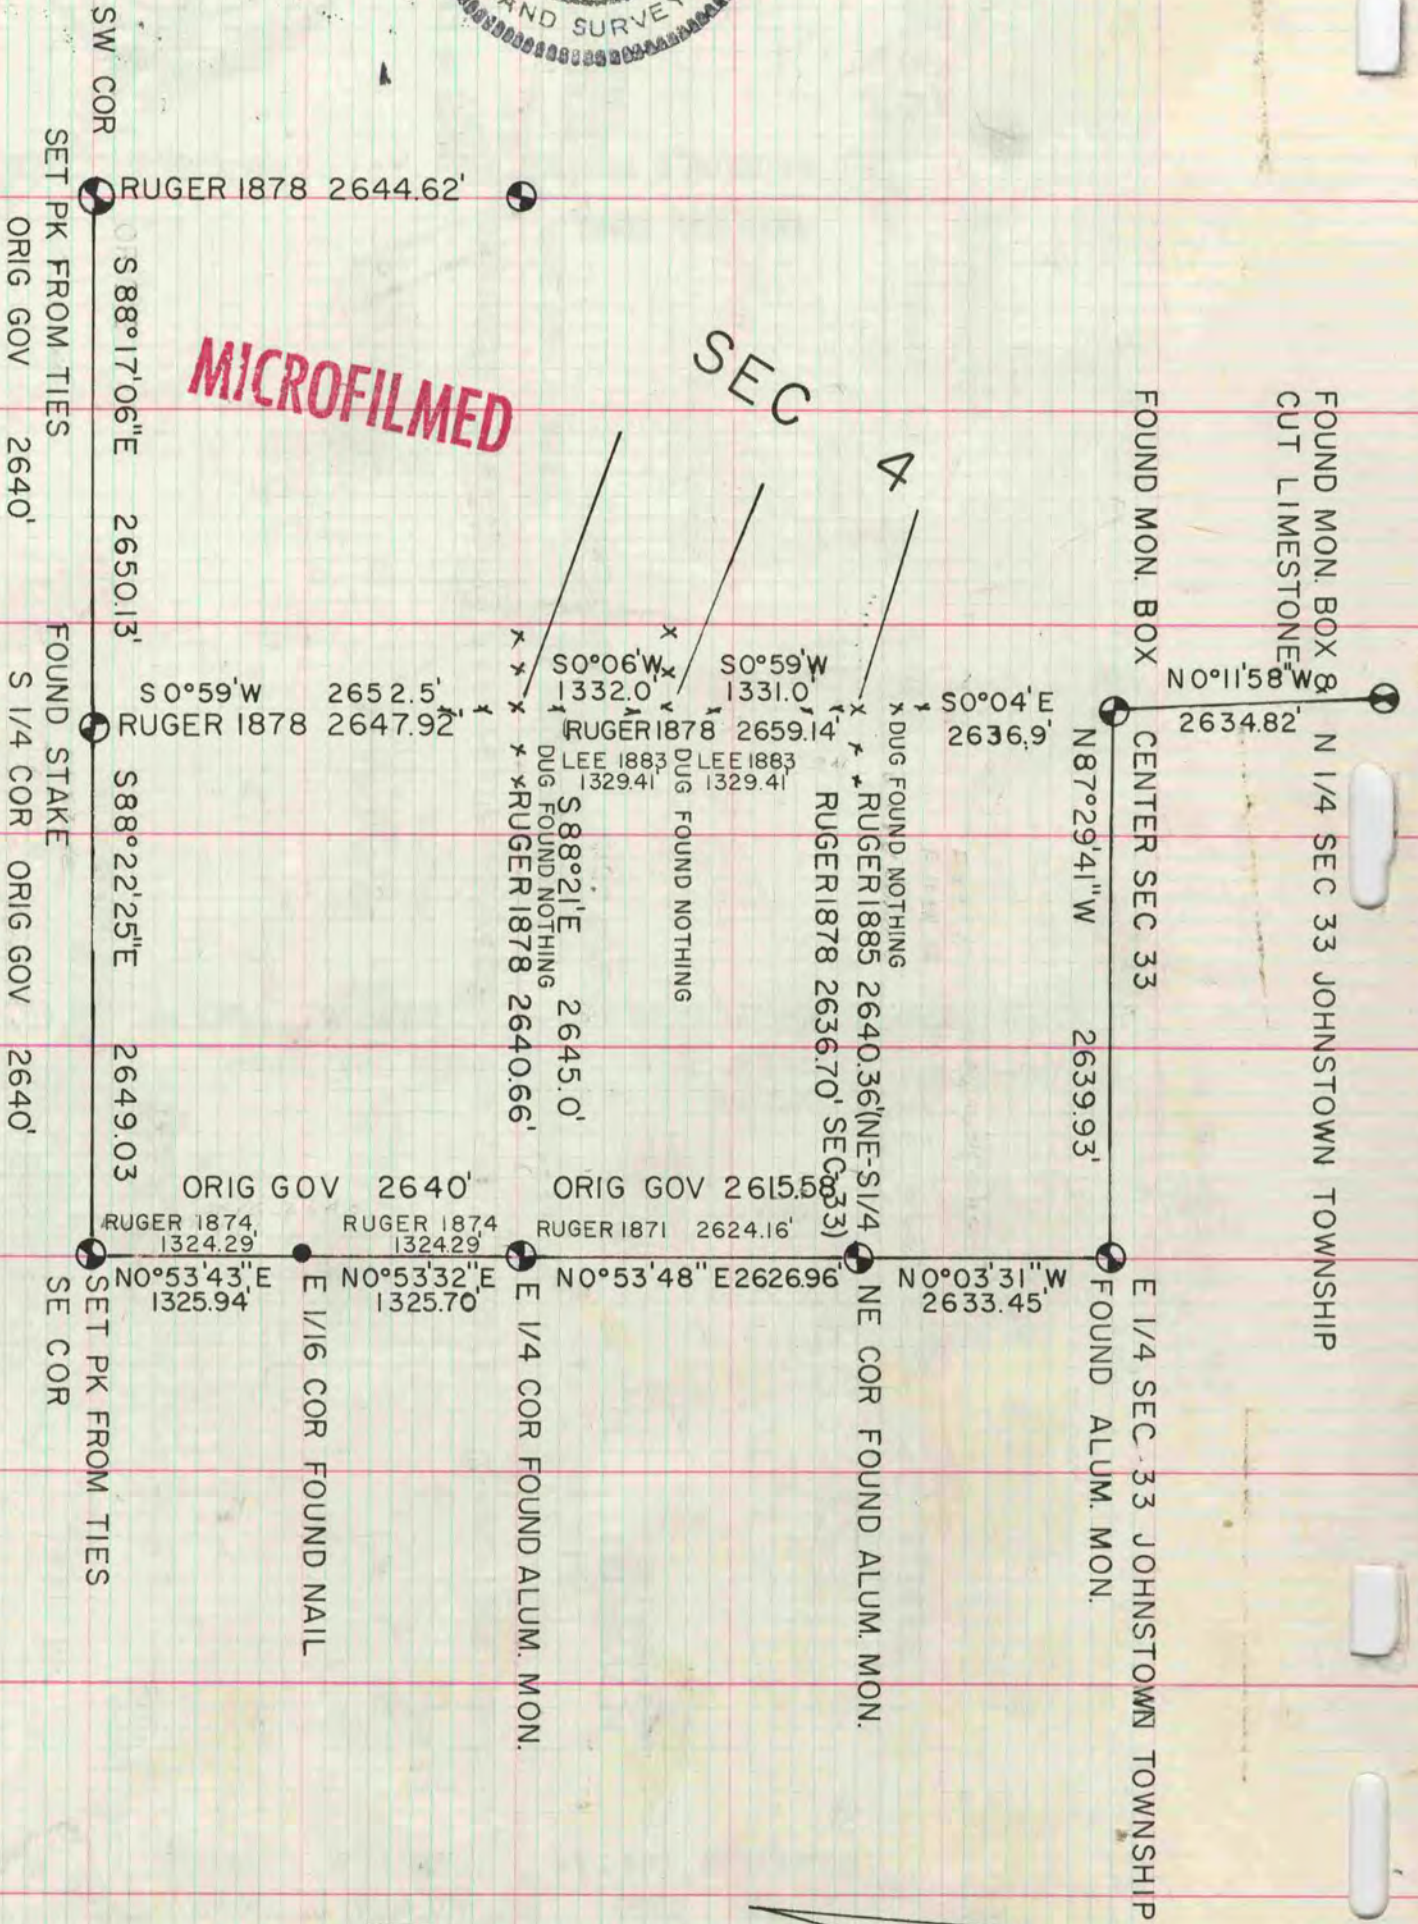

BEINGS AND DISTANCES ARE BASED ON A LOCAL COORDINATE SYSTEM.

