


PLAT AND RECORD

Of a Survey on Section 36 T 3 R 10 E. of the 4 P. M. in Magnolia Township
Rock County, Wisconsin, made July the 8th 1870

I hereby certify that the following is a correct record of said survey as made by me.

COUNTY BUILDING
CITY OF JANESVILLE

(Signed) Edward Roger Deputy
R.H.B. County Surveyor.

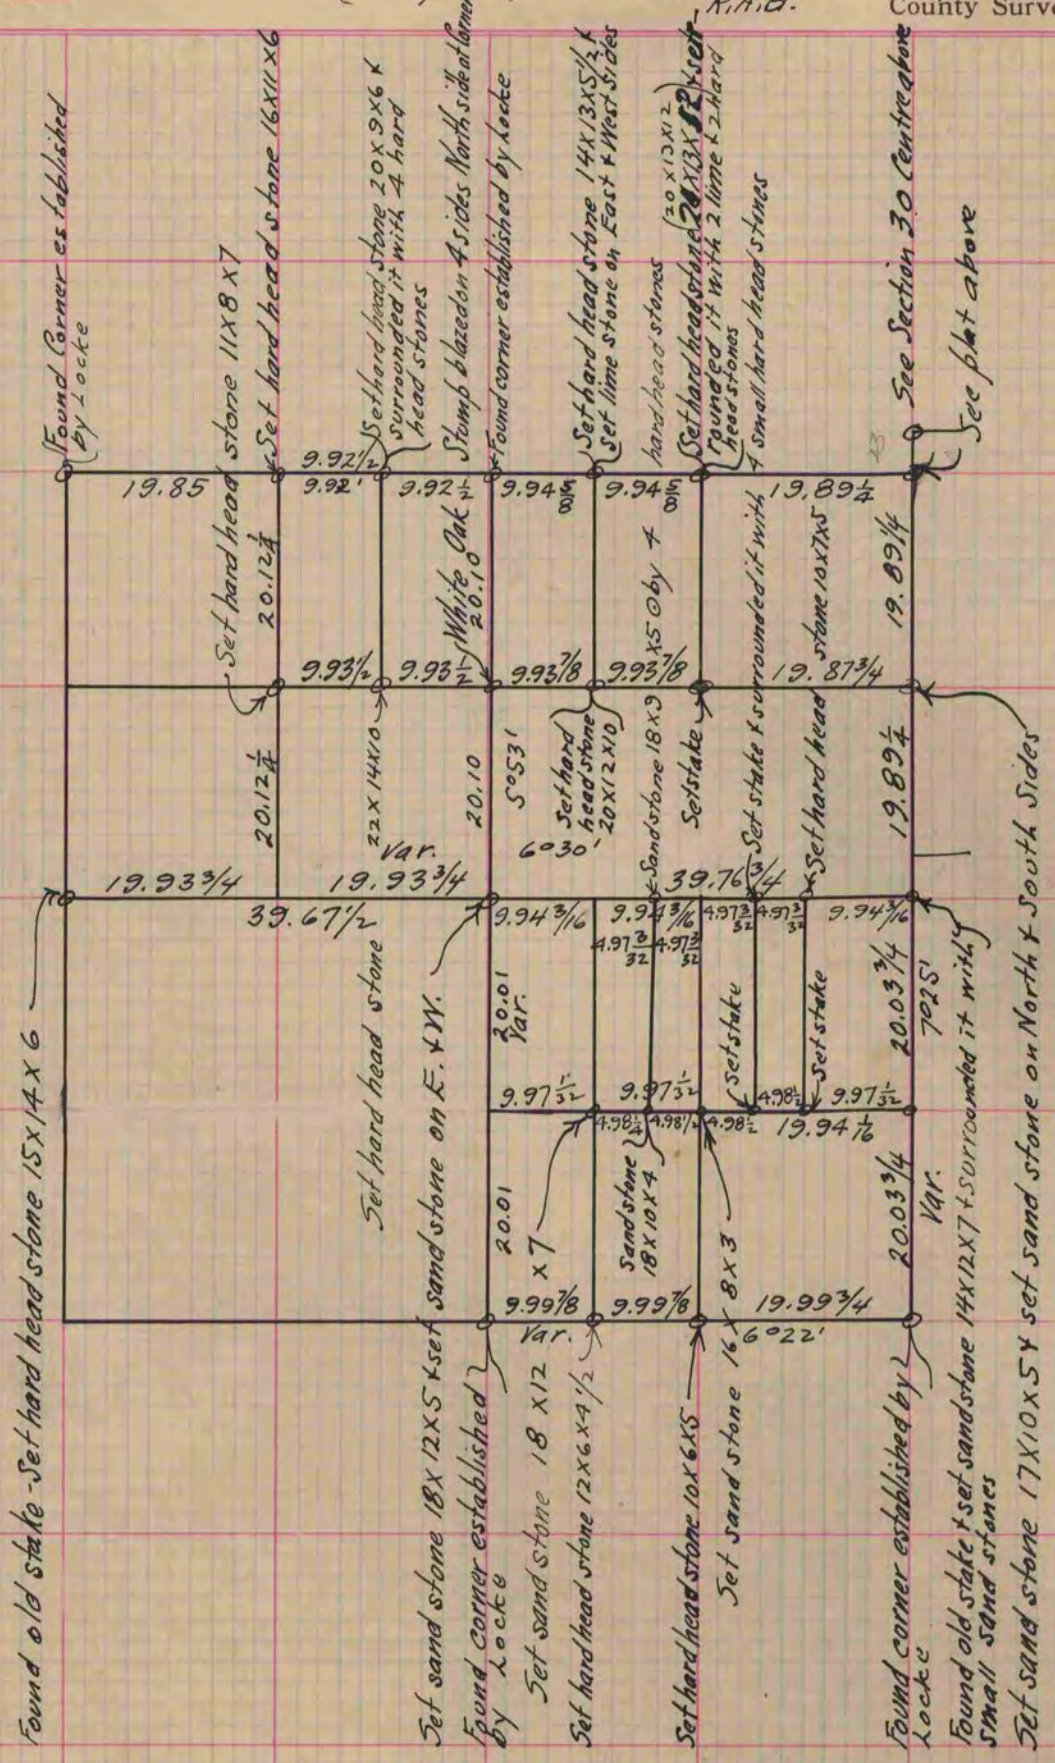

Copied from Power's P. 25 Vol. 2 Original County Surveyors Record