

MICROFILMED

# PLAT AND RECORD


Of a Survey on Sections 2 + 11 T 3 R 12 E. of the 4 P. M. in Janesville Township

Rock County, Wisconsin, made May 29 & the 30 1890

I hereby certify that the following is a correct record of said survey as made by me.

COUNTY BUILDING  
CITY OF JANESVILLE

(Signed) O. G. Bleedorn Dep.  
R. H. B. County Surveyor.

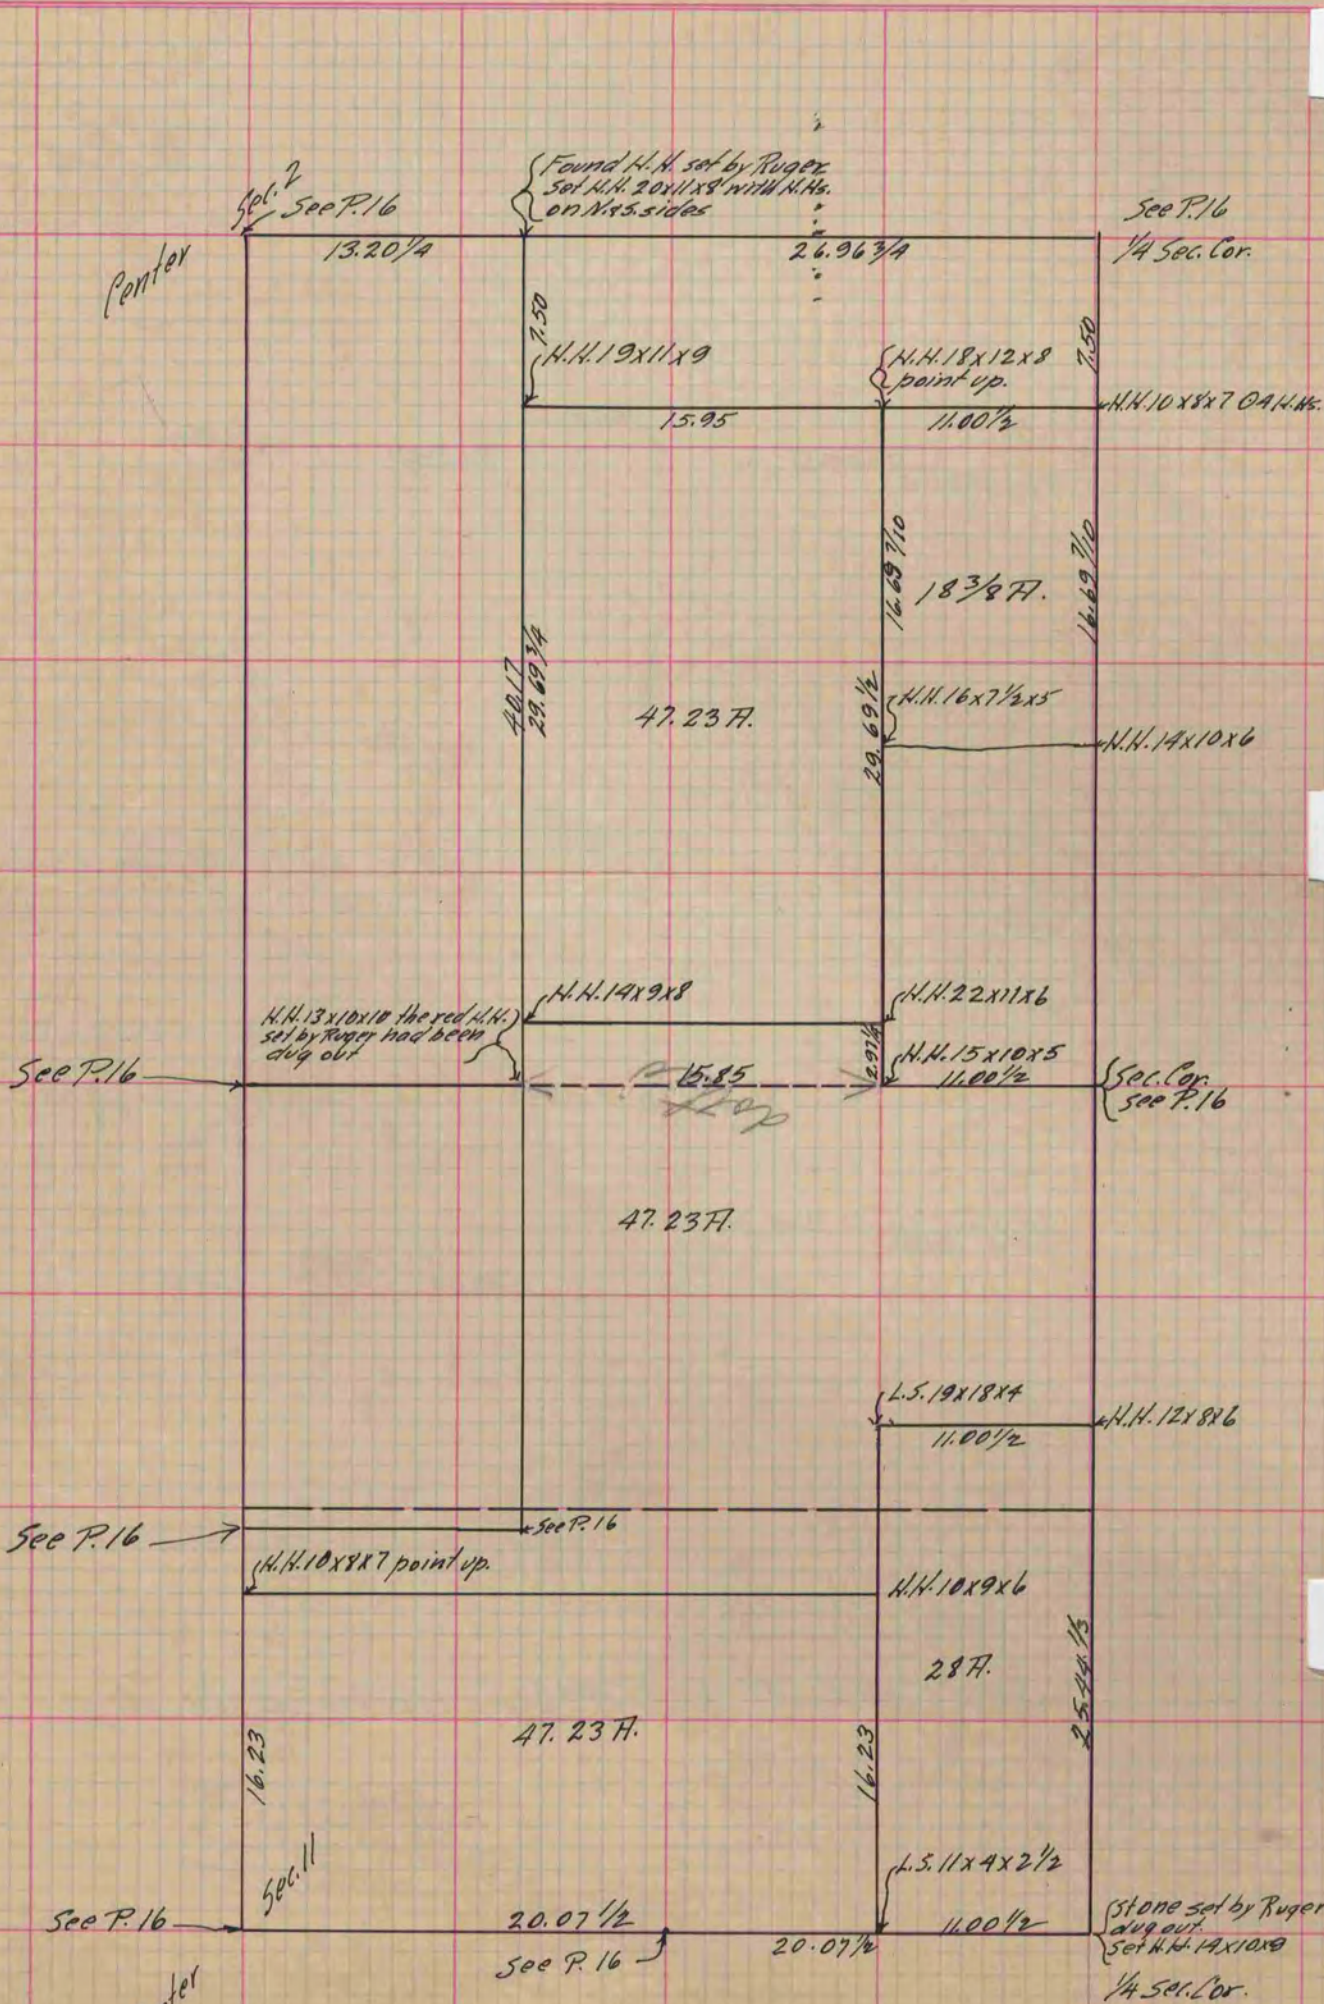

Copied from Page 351 County Surveyor's Record.