

PLAT AND RECORD

MICROFILMED

COUNTY BUILDING
CITY OF JANESVILLE


Of a Survey on Section 13 T A R 13 E. of the 4 P. M. in Milton Township

Rock County, Wisconsin, made _____ the _____ 19____

I hereby certify that the following is a correct record of said survey ~~as made by me.~~

(Signed) P.F. Brown
R.H.B. County Surveyor.

Taken from notes of O.G. Bleedorn.

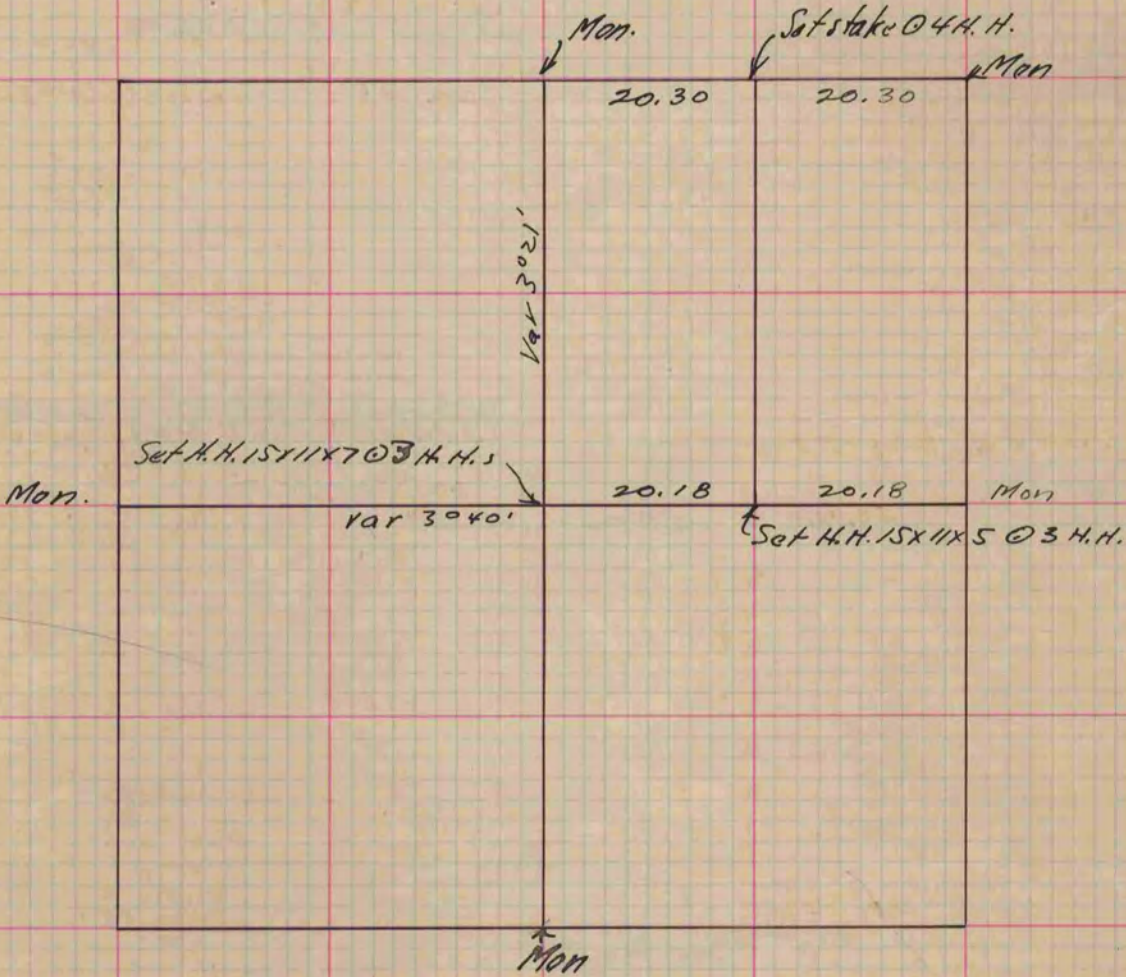

Copied from P. 380 Vol. 2. County Surveyors Record.