

MICROFILMED

PLAT AND RECORD

COUNTY BUILDING
CITY OF JANESVILLE


Of a Survey on Section 6 T 1 R 13 E. of the 4 P. M. in Turtle Township

Rock County, Wisconsin, made Nov. the 1882

I hereby certify that the following is a correct record of said survey as made by me.

(Signed) J. A. Holmes
R. H. B. County Surveyor.

Sec. 6 Turtle

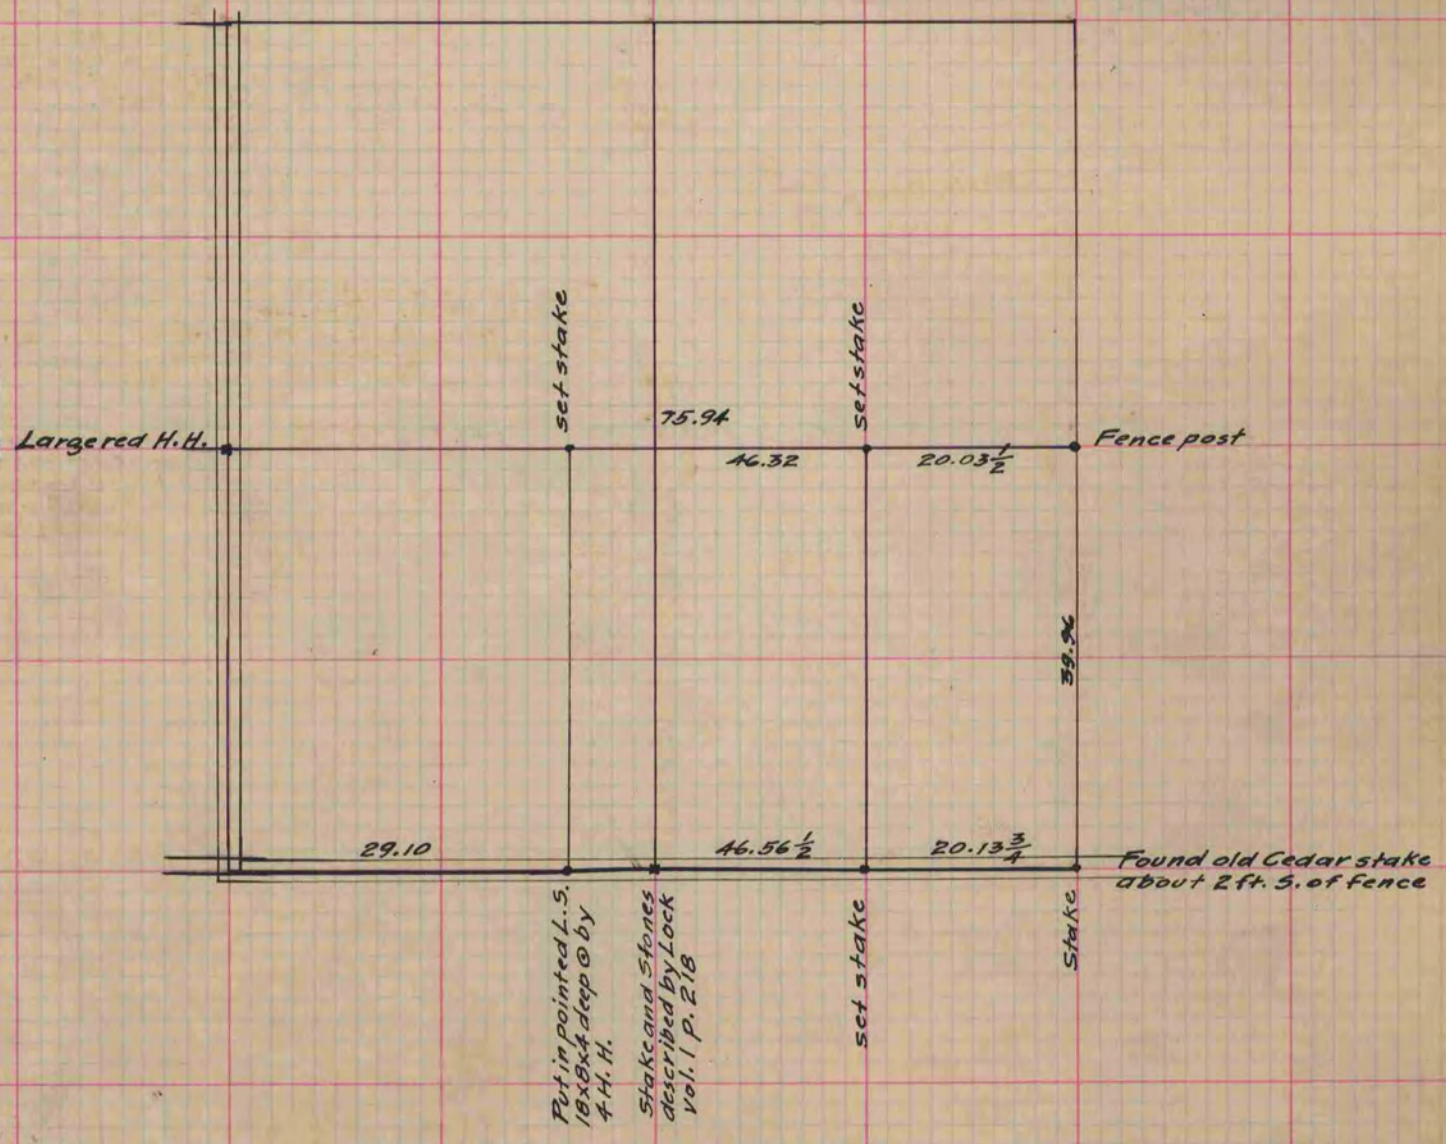

Copied from P. 287 Vol. 2 County Surveyors Record