

# PLAT AND RECORD

239

v-5


Of a Survey on Section 17 T. 3 R. 14 E. of the 4 P. M. in JOHNSTOWN Township

Rock County, Wisconsin, made JAN the 18 1977

I hereby certify that the following is a correct record of said survey as made by me.

COUNTY BUILDING  
CITY OF JANESVILLE

MICROFILMED

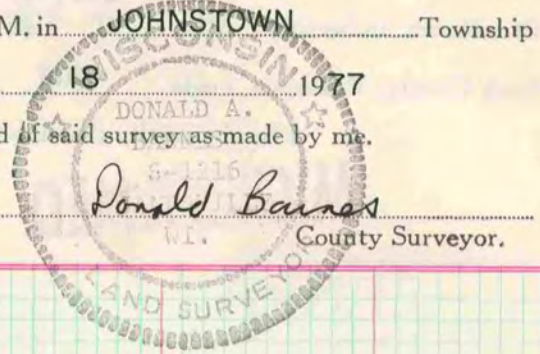

N 1/4 cor sec 17 Johnstown Twp  
fd iron rod with flagging, set 1 1/2" x 24" I.P.

